IREDELL COUNTY HEALTH DEPARTMENT

STATESVILLE 704-878-5305 MOORESVILLE 704-664-5281

IMPROVEMENT PERMIT / CERTIFICATE OF COMPLETION / OPERATION PERMIT / EXISTING SYSTEM INSPECTION

PROPERTY DESCRIPTION NO. REPAIR DATE 6/23/97 TAX MAP NO. REPAIR Watershed: ☑ Yes ☐ No

OWNER OR CONTRACTOR JIM CHEEK PHONE: Business Home 663-1259

ADDRESS 266 COMMODORE LOOP

LOCATION BRAWLEY SCHOOL - TL STUTS - TL COMMODORE - # 266 4635-69-9780

SUBDIVISION COMMODORE PEN. BLOCK / SECTION LOT 166+167 169 LOT AREA SITE CLASS. PS DESIGN FLOW 360 L.T.A.R.

Septic Tank: EXISTING Gallons; STB Date

Pump Tank: Gallons; PT Date

Pump Make: Model Serial No.

Nitrification Field: No Fields 1 Square Feet 600 Linear Feet 200

No Lines 4 @ 50' Trench Width 12' Max Trench Bottom Depth AS NEEDED Gravel Depth N/A

☐ New System ☑ Repair System Type: I, II, (III), IV, V, VI

System Description:

Repair System Description: GRAVITY CHAMBERS

Maintenance Agreement Required: ☐ Yes ☐ No

☑ House/Mod. Home No. Bedrooms 3

☐ Mobile Home No. Bathrooms 2

☐ Business No. Employees

☐ Other


☐ Slab ☐ Crawl Space ☐ Basement w/plumbing ☐ Basement wo/plumbing

Water Supply:
☐ Individual
☐ Community
☑ Public

Comments: ~~TRACTOR TO~~
OLD SYSTEM THAT IS DUG OUT NEEDS TO BE PROPERLY DISPOSED OF IN LANDFILL.

Comments:

INITIAL SITE SKETCH

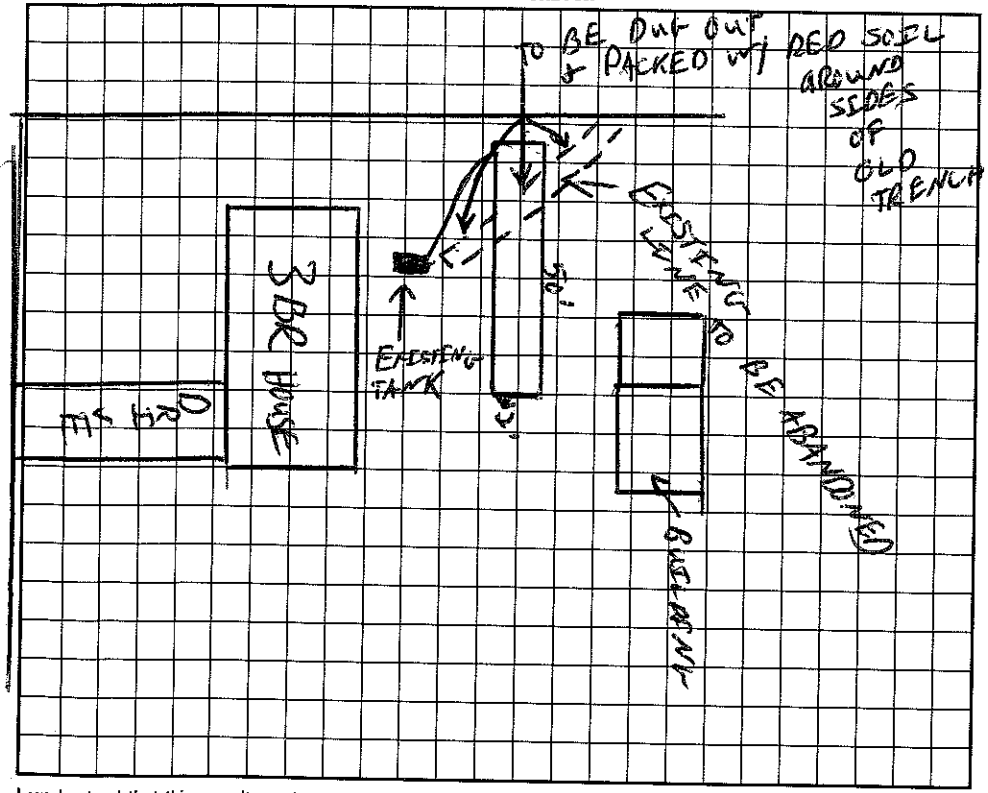

AS BUILT SKETCH

I understand that this permit can be suspended or revoked if any false information is supplied toward securing the permit/any unauthorized changes are made to the site/any unauthorized changes are made in the installation of the system. Improvement Permit is valid for 60 months from date of issuance.

Signed: T. Cheek

Improvement Permit by: date 6/23/97

Existing System Inspection by: date 6/23/97

Installed by: Richard Abernathy

Certificate of Completion by: date

Operation Permit by: Wesley Sparks R.S. date 5/16/97

HEALTH DEPT. COPY: WHITE INSPECTION COPY (FINAL): GREEN OWNER COPY (FINAL): YELLOW INSPECTION COPY (INITIAL): PINK OWNER COPY (INITIAL): GOLD

COMMODORE