IREDELL COUNTY HEALTH DEPARTMENT

STATESVILLE 704-878-5305 MOORESVILLE 704-664-5281

IMPROVEMENT PERMIT / AUTHORIZATION TO CONSTRUCT / OPERATION PERMIT / EXISTING SYSTEM INSPECTION

PERMIT# 070231 PIN# 4635 70 4510

OWNER OR CONTRACTOR Quinton Dandy DATE 2/23/99

ADDRESS 20468 E Chantwell Ct Dr. Cornelius, NC. PHONE: Business 892-0015 Home

LOCATION 145 Waterview Lane, Longstreet Rd. TR Waterview last lot on (L)

SUBDIVISION No BLOCK / SECTION LOT No LOT AREA ~1Ac SITE CLASS PS DESIGN FLOW 480 L.T.A.R. .3

Septic Tank: 1500 Gallons; STB 338 Date 9/9/99

Pump Tank: 1000 Gallons; PT AWS 27 Date 10/3/99 AWS

Pump Make: Goulds Model M7E0-511 100 WE Serial No A9021174300

Nitrification Field: AWS No Fields 1 Square Feet ~~1350~~ Linear Feet ~~450~~

No Lines ~~Mod 42~~ 42 Trench Width 36" Max Trench Bottom Depth 36" Gravel Depth SAND

[X] New System [ ] Repair System Type: I, II, [III], IV, V, VI

System Description: PressMan to Ch 7 Plastic

Repair System Description: PP BS

Maintenance Agreement Required: [ ] Yes [X] No

[X] House/Mod. Home No. Bedrooms 3

[ ] Mobile Home No. Bathrooms 3

[ ] Business No. Employees

[X] Other 1BD OVER GARAGE

[ ] Slab [X] Crawl Space [ ] Basement w/plumbing [ ] Basement wo/plumbing


Water Supply: [ ] Individual [ ] Public [ ] Community

Comments:/Conditions: 4 BD. Total


11/9/99 House only 3BD. Changed to 6 to 7 lines 40-42' long of HDS of Chamber Plastic AWS

Comments:/Conditions:

INITIAL SITE SKETCH

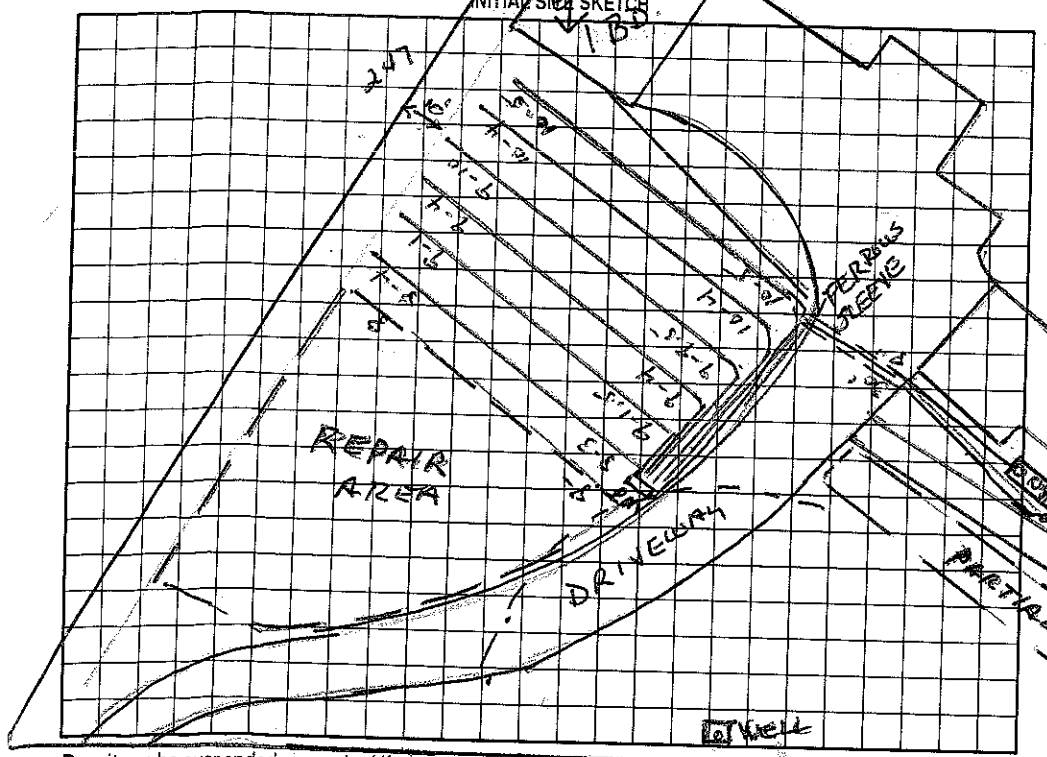

AS BUILT SKETCH

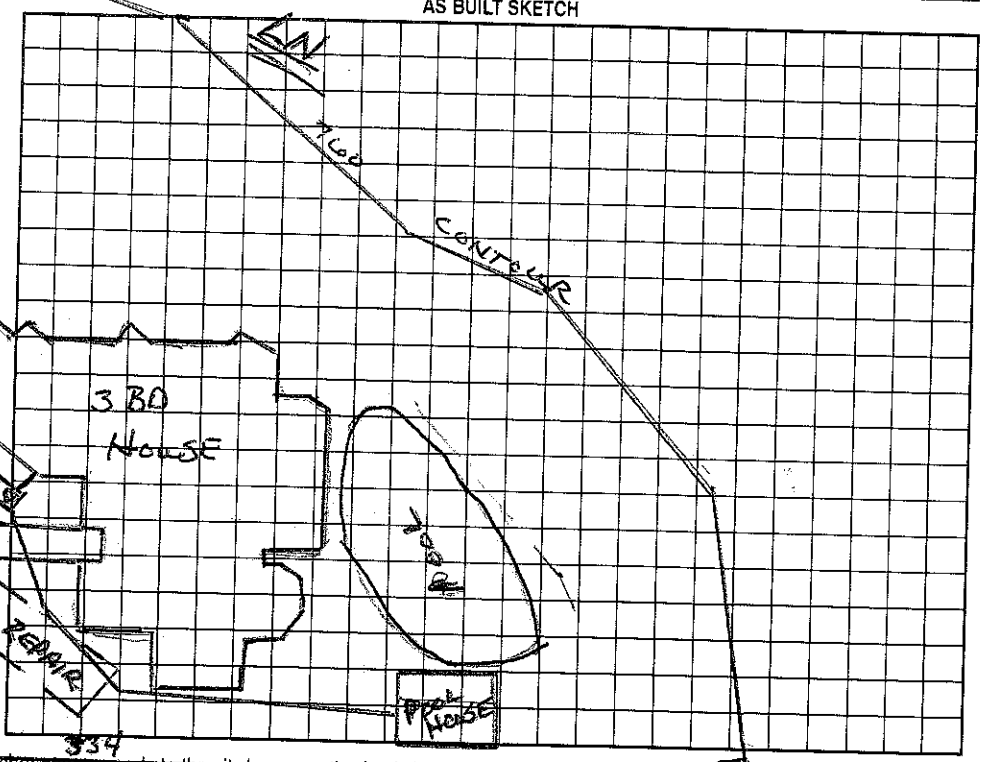

Permit can be suspended or revoked if any false information is supplied toward securing the permit/any unauthorized changes are made to the site/any unauthorized changes are made in the installation of the system. Improvement Permit with plat valid without expiration. Improvement Permit with site plan valid for sixty months. Authorization to Construct is valid for a period equal to that of Improvement Permit – not to exceed sixty months.

Signed: [signature] date 3/1/99 Installed by: F.T. Erwin

Improvement Permit by: date

Authorization to Construct by: Wesley Sparks R.S. date 2/23/99 Operation Permit by: Wesley Sparks R.S. date 11/15/99

Existing System Inspection by: date

HEALTH DEPT. COPY: WHITE OWNER COPY (FINAL): YELLOW OWNER COPY (INITIAL): PINK