IREDELL COUNTY HEALTH DEPARTMENT

STATESVILLE 704-878-5305 130.00 Paid MOORESVILLE 704-664-5281

Larry 634-2450

IMPROVEMENT PERMIT / AUTHORIZATION TO CONSTRUCT / OPERATION PERMIT / EXISTING SYSTEM INSPECTION

PERMIT# 106459 PIN# 4635 70 6185 DATE 6/5/02

OWNER OR CONTRACTOR Robert + Cynthia Howard PHONE: Business Home 704-664-3915

ADDRESS 110 Centre Church Rd. Mooresville, NC. 28117

LOCATION Williamson ST TR Moore TR Lengthen TR 2nd entrance Lakeshore, 2nd house on (L)

SUBDIVISION Lakeview Shores BLOCK / SECTION LOT 5-C LOT AREA .5 Ac SITE CLASS PS DESIGN FLOW 480 L.T.A.R. .3

Septic Tank: 1000 Gallons: STB 312 Date 9-1-03
Pump Tank: Gallons: PT Date
Pump Make: Model Serial No.
Nitrification Field: No Fields 1 Square Feet 1200 * Linear Feet 400 *
No Lines 5 @ 80' Trench Width 3' Max Trench Bottom Depth 3' Gravel Depth No

[X] New System [ ] Repair System Type: I, II, (III), IV, V, VI
System Description: GRAVITY - Type 3
Repair System Description: SAME
Maintenance Agreement Required: [ ] Yes [X] No

[X] House/Mod. Home No. Bedrooms 4
[ ] Mobile Home No. Bathrooms 3
[ ] Business No. Employees
[ ] Other
[ ] Slab [X] Crawl Space [ ] Basement w/plumbing [ ] Basement wo/plumbing


Water Supply: [X] Individual [ ] Public [ ] Community

Comments:/Conditions:


Comments:/Conditions: Checked upper 2 lines AM 10/3/03
remaining 3 lines checked in PM

(1" = 40')

INITIAL SITE SKETCH

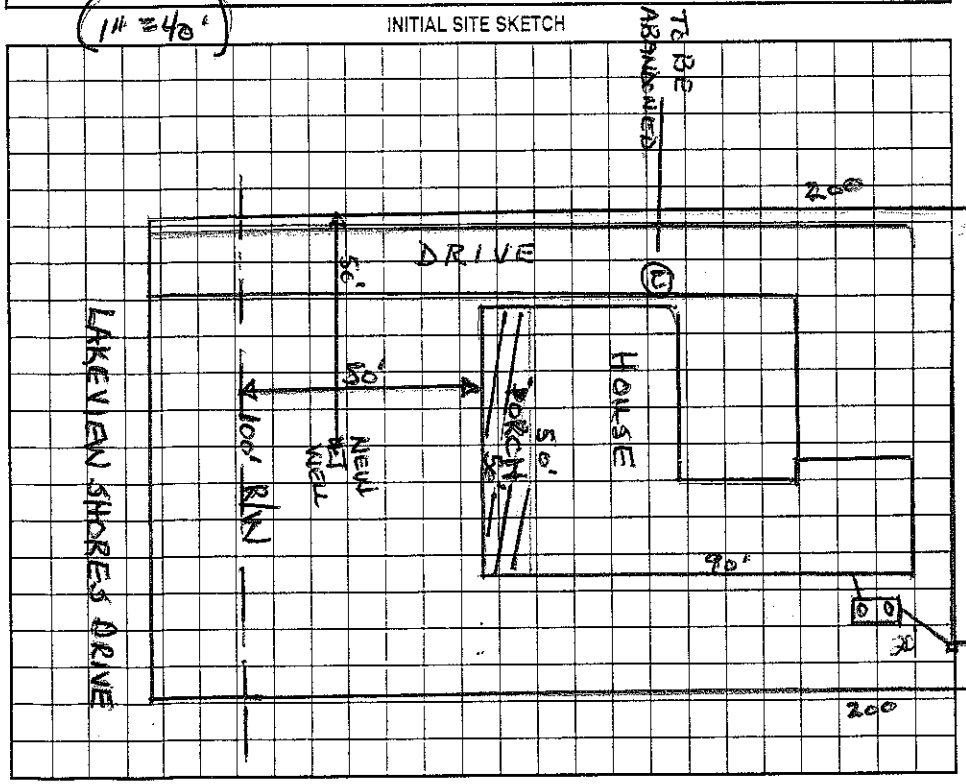

AS BUILT SKETCH

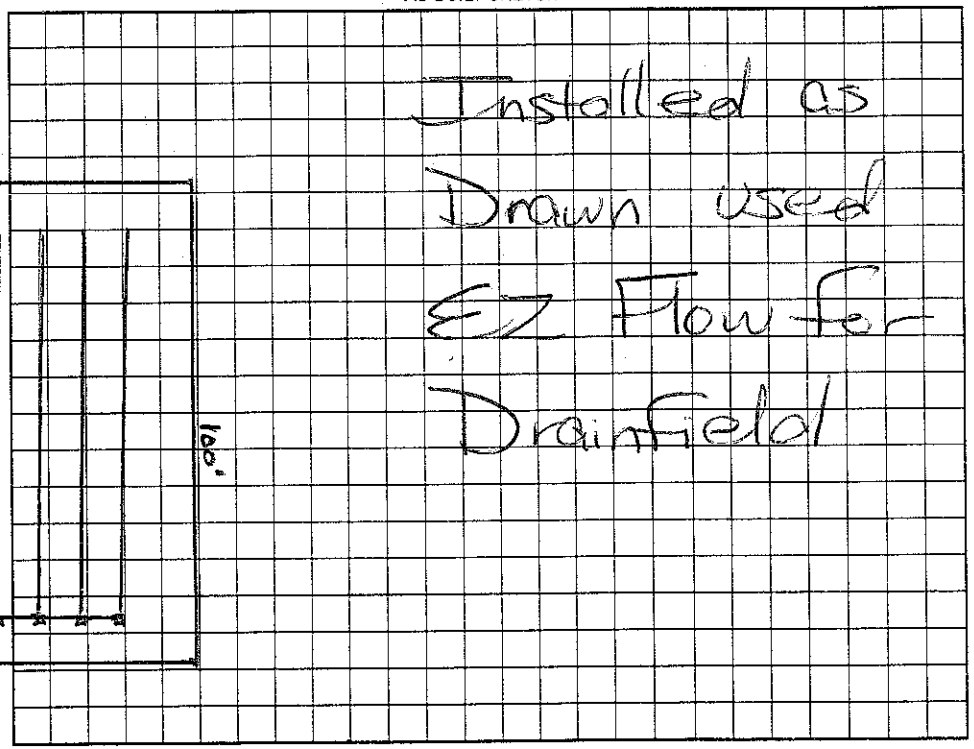

Permit can be suspended or revoked if any false information is supplied toward securing the permit/any unauthorized changes are made to the site/any unauthorized changes are made in the installation of the system. Improvement Permit with plat valid without expiration. Improvement Permit with site plan valid for sixty months. Authorization to Construct is valid for a period equal to that of Improvement Permit – not to exceed sixty months.

Signed: * Cynthia Howard date 6/12/02 Installed by: Larry Hinkle

Improvement Permit by: Wesley Sparks RS. date 6/5/02 Operation Permit by: Maria Hilderbran RS. date 10/3/03

Authorization to Construct by: Wesley Sparks RS. date 6/5/02 Existing System Inspection by: date

HEALTH DEPT. COPY: WHITE OWNER COPY (FINAL): YELLOW OWNER COPY (INITIAL): PINK