IREDELL COUNTY HEALTH DEPARTMENT

AUTHORIZATION TO CONSTRUCT

STATESVILLE 704-878-5305 MOORESVILLE 704-664-5281

4700

IMPROVEMENT PERMIT / ~~CERTIFICATE OF COMPLETION~~ / OPERATION PERMIT / EXISTING SYSTEM INSPECTION

PROPERTY DESCRIPTION NO. 20359 DATE 11/4/97 TAX MAP NO. 2B1C32 Watershed: ☐ Yes ☐ No

OWNER OR CONTRACTOR GREG HEINRICHER ~~PHONE: Business~~ 4635-70-9048 Home

ADDRESS MOORESVILLE

LOCATION LANE TREE - 2ND LAKESHORE DR - 200' ON RT

SUBDIVISION LAKEVIEW SHORES BLOCK / SECTION LOT 32 LOT AREA ~ 27000 ft² SITE CLASS. A5 DESIGN FLOW 360 L.T.A.R. .3

Septic Tank: 1000 Gallons; STB 825 Date 1/11/98

Pump Tank: Gallons; PT Date

Pump Make: Model Serial No.

Nitrification Field: No Fields 1 Square Feet 900 Linear Feet 300

No Lines 4 @ 75' Trench Width 36" Max Trench Bottom Depth 30" Gravel Depth N/A

☑ New System ☐ Repair System Type: I, II, (III), IV, V, VI

System Description: GRAVITY CHAMBERED OR HDS

Repair System Description: PANEL

Maintenance Agreement Required: ☐ Yes ☑ No

☑ House/Mod. Home No. Bedrooms 3

☐ Mobile Home No. Bathrooms 2

☐ Business No. Employees

☐ Other


☐ Slab ☑ Crawl Space ☐ Basement w/plumbing ☐ Basement wo/plumbing

Water Supply: ☑ Individual ☐ Community ☐ Public

Comments: REVISED

Comments:

INITIAL SITE SKETCH 1" = 50'

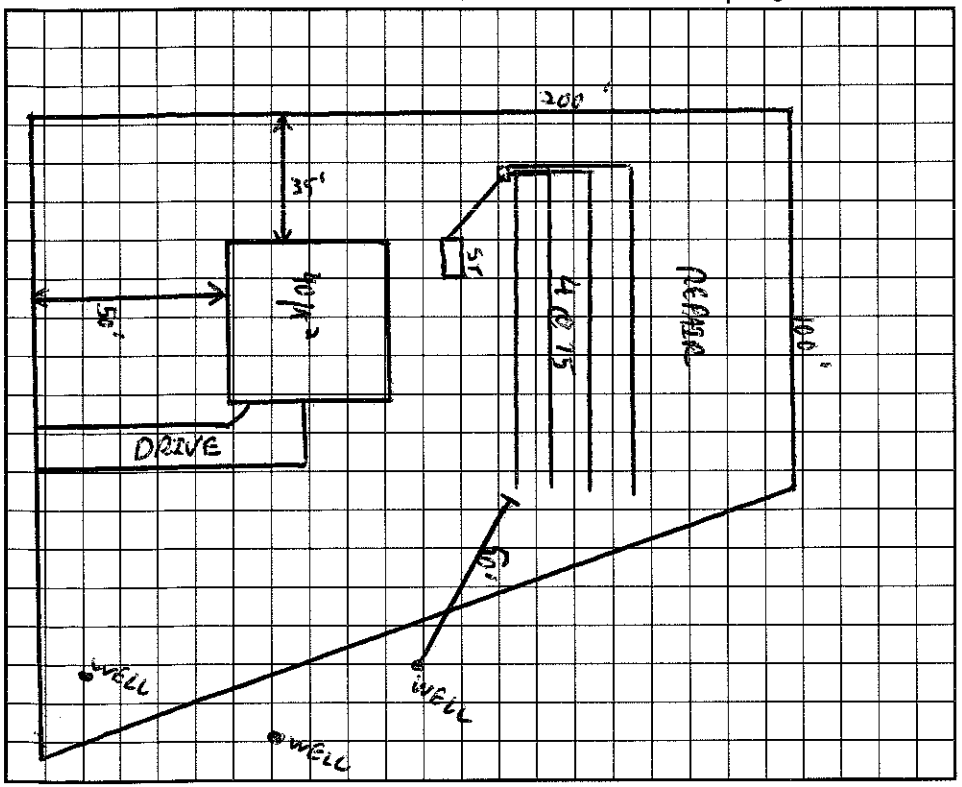

AS BUILT SKETCH

I understand that this permit can be suspended or revoked if any false information is supplied toward securing the permit/any unauthorized changes are made to the site/any unauthorized changes are made in the installation of the system. Improvement Permit is valid for 60 months from date of issuance.

Signed:

Improvement Permit by: date 11/4/97

AUTHORIZATION TO CONSTRUCT Existing System Inspection by: date 11/4/97

Installed by: BOSTAIN

Certificate of Completion by: date

Operation Permit by: date 3/31/98

HEALTH DEPT. COPY: WHITE INSPECTION COPY (FINAL): GREEN OWNER COPY (FINAL): YELLOW INSPECTION COPY (INITIAL): PINK OWNER COPY (INITIAL): GOLD