IREDELL COUNTY HEALTH DEPARTMENT

STATESVILLE 704-878-5305 MOORESVILLE 704-664-5281

IMPROVEMENT PERMIT / ~~CERTIFICATE OF COMPLETION~~ / OPERATION PERMIT / EXISTING SYSTEM INSPECTION

PROPERTY DESCRIPTION NO. 21642 DATE 10/7/96 TAX MAP NO. 23A 20 4635 719596 Watershed: X Yes ☐ No

OWNER OR CONTRACTOR Daniel Hagerman PHONE: Business 662-3052 Home

ADDRESS 1430 Pinewoodale Dr. Mooresville, NC. 28115

LOCATION Langtree Rd. TR Lakeshore Dr. TR Viewpoint Ln. to end on (R)

SUBDIVISION Lakeshore Shores BLOCK / SECTION C LOT 20 LOT AREA ~48000 FT² SITE CLASS. PS DESIGN FLOW ~~480~~ 480.00 L.T.A.R. .35

Septic Tank: 1000 Gallons; STB 794 Date 9/97
Pump Tank: 1000 Gallons; PT 27 Date 9/97
Pump Make: ZOELLER Model N988 Serial No. 360
Nitrification Field: No Fields 1 Square Feet 1391 Linear Feet ~~345~~
No Lines 4 Trench Width 36" Max Trench Bottom Depth 36" Gravel Depth 3&4O

X New System ☐ Repair System Type: I, II, III, IV, V, VI
System Description: ~~X~~ CH PLASTIC - PRES MANIFOLD
Repair System Description: SAME
Maintenance Agreement Required: ☐ Yes ☐ No


X House/Mod. Home No. Bedrooms 4
☐ Mobile Home No. Bathrooms 3.5
☐ Business No. Employees
☐ Other

☐ Slab X Crawl Space ☐ Basement w/plumbing ☐ Basement wo/plumbing

Water Supply:
X Individual
☐ Community
☐ Public

Comments: LN TEL CONTROL

INITIAL SITE SKETCH

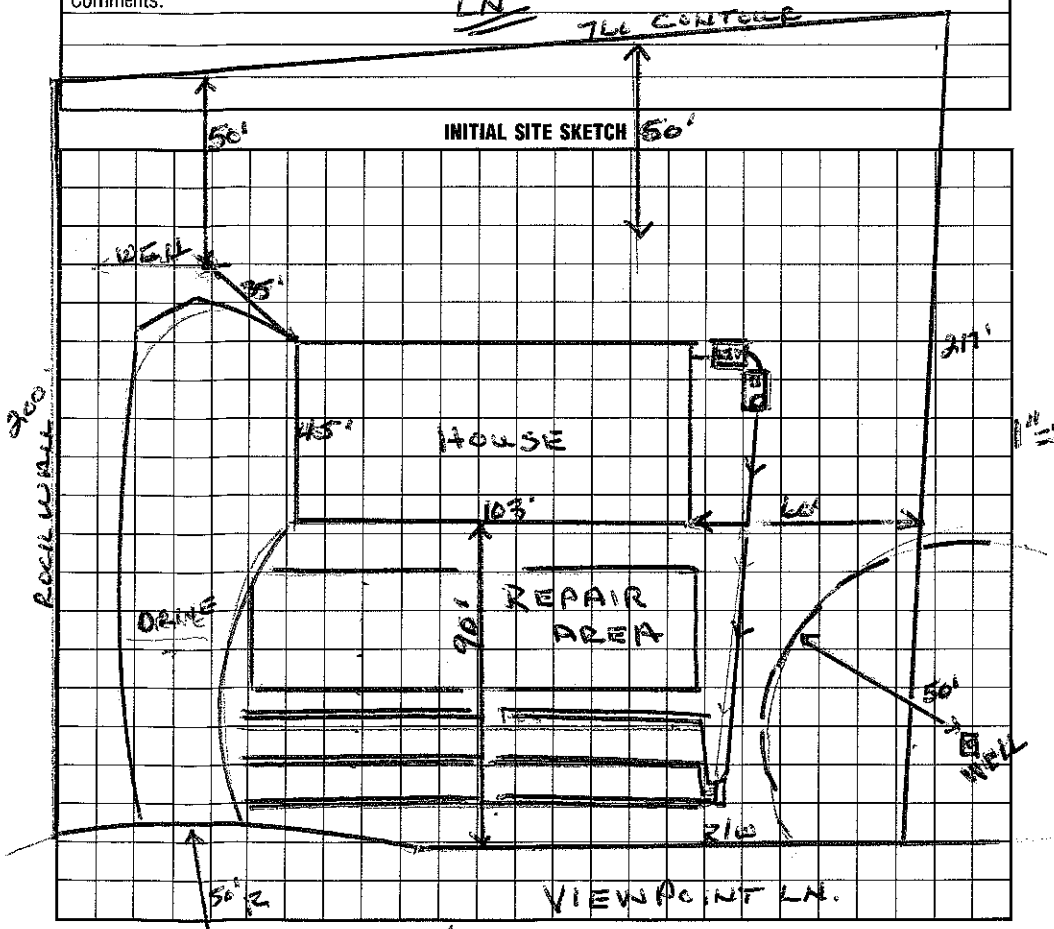

Comments:

AS BUILT SKETCH

I understand that this permit can be suspended or revoked if any false information is supplied toward securing the permit/any unauthorized changes are made to the site/any unauthorized changes are made in the installation of the system.

Signed: X Daniel Hagerman

Improvement Permit by: Wesley Sparks RS. date 10/8/96

~~Certificate of Completion by:~~ Wesley Sparks RS. date 10/8/96

Installed by: D + M Enterprises

Certificate of Completion by: Wesley Sparks RS date 1/20/98

Operation Permit by: Wesley Sparks RS. date 1/20/98

HEALTH DEPT. COPY: WHITE INSPECTION COPY (FINAL): GREEN OWNER COPY (FINAL): YELLOW INSPECTION COPY (INITIAL): PINK OWNER COPY (INITIAL): GOLD