IREDELL COUNTY HEALTH DEPARTMENT

STATESVILLE 704-878-5305 MOORESVILLE 704-664-5281

IMPROVEMENT PERMIT / AUTHORIZATION TO CONSTRUCT / OPERATION PERMIT / EXISTING SYSTEM INSPECTION

PERMIT# 1088819 PIN# 4635-79-0805 DATE 9/20/02

OWNER OR CONTRACTOR Spear Const. PHONE: Business 279-636-7954 Home

ADDRESS 607 Anderson Ave. Salisbury NC 28144

LOCATION Brawley Sch, TL Stutts TL 2nd Commodore, TL Mainview on Rt Across From Pompano

SUBDIVISION Commodore Pen. BLOCK / SECTION LOT 192 LOT AREA 0.23 AC SITE CLASS PS DESIGN FLOW 360 L.T.A.R. 0.35

Septic Tank: 1000 Gallons; STB 825 Date 9/24/02
Pump Tank: Gallons; PT Date
Pump Make: Model Serial No.
Nitrification Field: No Fields 1 Square Feet 780 Linear Feet 260
No Lines 5@52 Trench Width 36" Max Trench Bottom Depth 36"

☒ New System ☐ Repair System Type: I, II, (III), IV, V, VI
System Description: Gravity 25% Reduction
Repair System Description: <100% Need Prior to 1983
Maintenance Agreement Required: ☐ Yes ☒ No

☒ House/Mod. Home No. Bedrooms 3
☐ Mobile Home No. Bathrooms 2
☐ Business No. Employees
☐ Other


Gravel Depth —
☐ Slab ☒ Crawl Space ☐ Basement w/plumbing ☐ Basement wo/plumbing

Water Supply:
☐ Individual
☐ Public
☒ Community

Comments:/Conditions:

Comments:/Conditions:

INITIAL SITE SKETCH 1"=30'

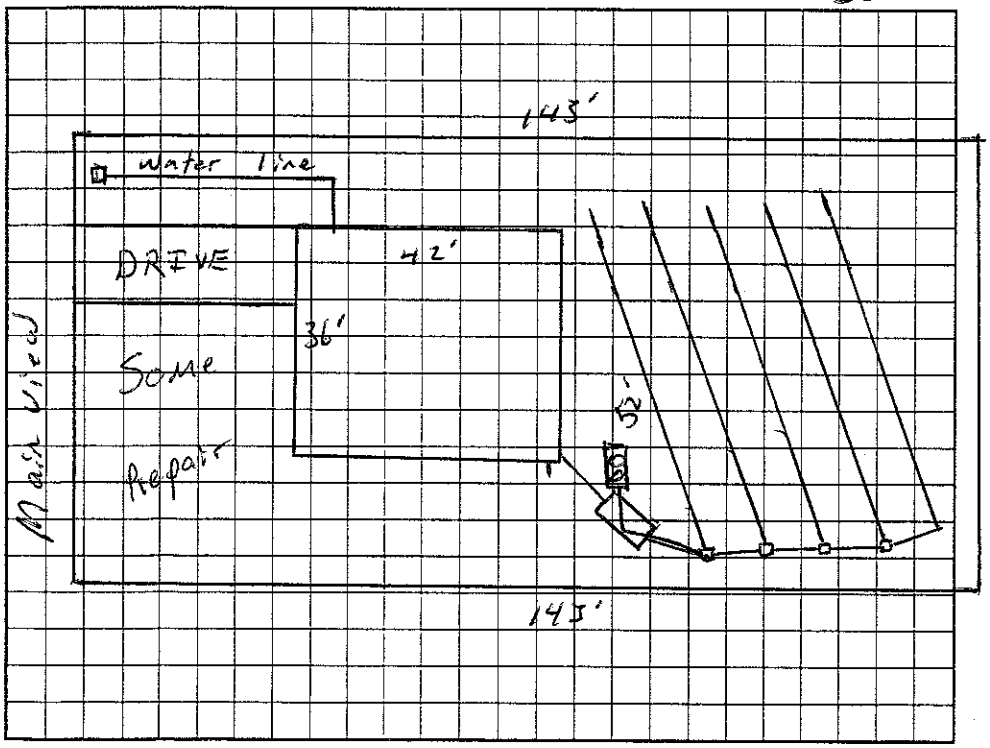

AS BUILT SKETCH

70'

Permit can be suspended or revoked if any false information is supplied toward securing the permit/any unauthorized changes are made to the site/any unauthorized changes are made in the installation of the system. Improvement Permit with plat valid without expiration. Improvement Permit with site plan valid for sixty months. Authorization to Construct is valid for a period equal to that of Improvement Permit – not to exceed sixty months.

Signed: date 9/27/02 Installed by: Rowan Septic Tank

Improvement Permit by: RS date 9/20/02 Operation Permit by: Wesley Sparks RS date 11/25/02

Authorization to Construct by: RS date 9/20/02 Existing System Inspection by: date

HEALTH DEPT. COPY: WHITE OWNER COPY (FINAL): YELLOW OWNER COPY (INITIAL): PINK