IREDELL COUNTY HEALTH DEPARTMENT

STATESVILLE 704-878-5305 MOORESVILLE 704-664-5281

IMPROVEMENT PERMIT / AUTHORIZATION TO CONSTRUCT / OPERATION PERMIT / EXISTING SYSTEM INSPECTION

PERMIT# 075249 PIN# 4635 79 2760 DATE 8/20/98

OWNER OR CONTRACTOR Jackie Lewis PHONE: Business 664-3926 Home

ADDRESS 708 Lake of Pines Rd. Mooresville, NC. 28117

LOCATION 1100 TL Stutts Rd. TL 2nd Commodore on (R) ~.5 mile

SUBDIVISION COMMODORE BLOCK / SECTION LOT 171 LOT AREA .23 AC SITE CLASS. PS DESIGN FLOW 360 L.T.A.R. .3

Septic Tank: 1000 Gallons; STB 794 Date 10/17/98
Pump Tank: Gallons; PT Date
Pump Make: Model Serial No.
Nitrification Field: No Fields 1 Square Feet 600± Linear Feet 200±
No Lines 4 Trench Width 36" Max Trench Bottom Depth 36" Gravel Depth SAND

[X] New System [ ] Repair System Type: I, II, (III) IV, V, VI
System Description: PPBS-GRAVITY
Repair System Description: SAME
Maintenance Agreement Required: [ ] Yes [X] No


[X] House/Mod. Home No. Bedrooms 3
[ ] Mobile Home No. Bathrooms 2
[ ] Business No. Employees
[ ] Other
[ ] Slab [X] Crawl Space [ ] Basement w/plumbing [ ] Basement wo/plumbing

Water Supply: [ ] Individual [ ] Public [X] Community

Comments:/Conditions:

Comments:/Conditions:

INITIAL SITE SKETCH (1" = 40')

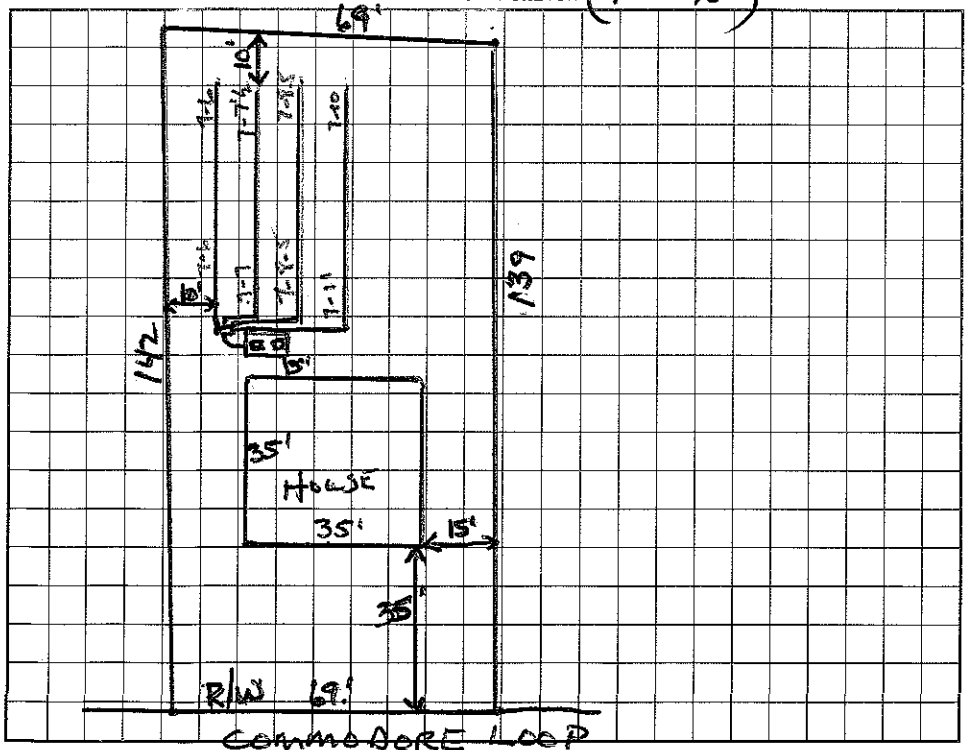

AS BUILT SKETCH

I understand that this permit can be suspended or revoked if any false information is supplied toward securing the permit/any unauthorized changes are made to the site/any unauthorized changes are made in the installation of the system. Improvement Permit with plat valid without expiration. Improvement Permit with site plan valid for sixty months. Authorization to Construct is valid for a period equal to that of Improvement Permit – not to exceed sixty months.

Signed: [signature] date 8/24/98 Installed by: MacLeod

Improvement Permit by: Wesley Sparks R.S. date 8/20/98 Operation Permit by: Wesley Sparks R.S. date 12/7/98

Authorization to Construct by: Wesley Sparks R.S. date 8/20/98 Existing System Inspection by: date

HEALTH DEPT. COPY: WHITE INSPECTION COPY (FINAL): GREEN OWNER COPY (FINAL): YELLOW INSPECTION COPY (INITIAL): PINK OWNER COPY (INITIAL): GOLD