IREDELL COUNTY HEALTH DEPARTMENT

Statesville Phone TR 3-7271 Mooresville Phone No. 664-5281

PERMIT TO INSTALL SEPTIC TANK

Permit No. 131 Permit Date 6 - 15 - 1973

Owner Mrs. Penry Address Charlatte

Installed By E. J. Ervin Address Mooresville

Location of Property Commodore Penn Th

aster water Tank Stay left ½ to ½


mion Right Lots 59+60

Tank		Capacity		Length of Lines		Fixtures	
Block	( )	1000	( )	225'	(✓)	No. of Baths	(2)
Precast	(✓)	1250	(✓)	250'	( )	Dishwasher	(no)
		1500	( )	Other		Garbage Grdr.	(no)
		Other				Other	Washing Machine

NOTIFY HEALTH DEPARTMENT AT LEAST EIGHT HOURS BEFORE TANK IS TO BE INSPECTED.

Final Inspection 6 - 15 - 1973 Approved (✓) Disapproved ( )

Remarks Community water System

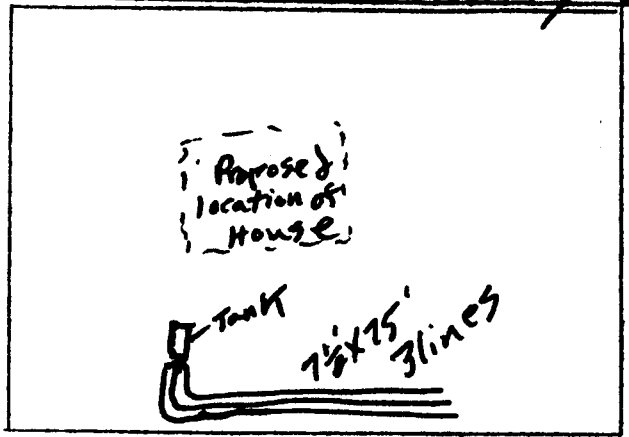

Sketch of Installation

J. C. Moore

Sanitarian