IREDELL COUNTY HEALTH DEPARTMENT

STATESVILLE 704-878-5305 MOORESVILLE 704-664-5281

IMPROVEMENT PERMIT / AUTHORIZATION TO CONSTRUCT / OPERATION PERMIT / EXISTING SYSTEM INSPECTION

PERMIT# 075248 PIN# 4635 79 3639 DATE 8/20/98

OWNER OR CONTRACTOR Apple Development PHONE: Business 664-5926 Home

ADDRESS 708 Dale of Pines Rd. Mooresville, NC. 28117

LOCATION 1100 TL Stutts Rd. TL 2ND COMMODORE LOOP ~.5 mile on (L) 248 commodore loop

SUBDIVISION COMMODORE BLOCK / SECTION LOT 172 LOT AREA .23 AC SITE CLASS. PS DESIGN FLOW 360 L.T.A.R. .3

Septic Tank: 1000 Gallons; STB 794 Date 8/12/98
Pump Tank: 1000 Gallons; PT 29 Date 10/27/98
Pump Make: HYDRomatic Model SK50A1 Serial No. 2/98
Nitrification Field: No Fields 1 Square Feet 600* Linear Feet 200*
No Lines 5 Trench Width 36" Max Trench Bottom Depth 36"

[X] New System [ ] Repair System Type: I, II, (III), IV, V, VI
System Description: Pressure - 16" PPBS
Repair System Description:
Maintenance Agreement Required: [ ] Yes [ ] No

[X] House/Mod. Home No. Bedrooms 3
[ ] Mobile Home No. Bathrooms 2
[ ] Business No. Employees
[ ] Other


Gravel Depth SAND. [ ] Slab [X] Crawl Space [ ] Basement w/plumbing [ ] Basement wo/plumbing

Water Supply: [ ] Individual [ ] Public [X] Community

Comments:/Conditions:

Comments:/Conditions:

INITIAL SITE SKETCH (1"=40')

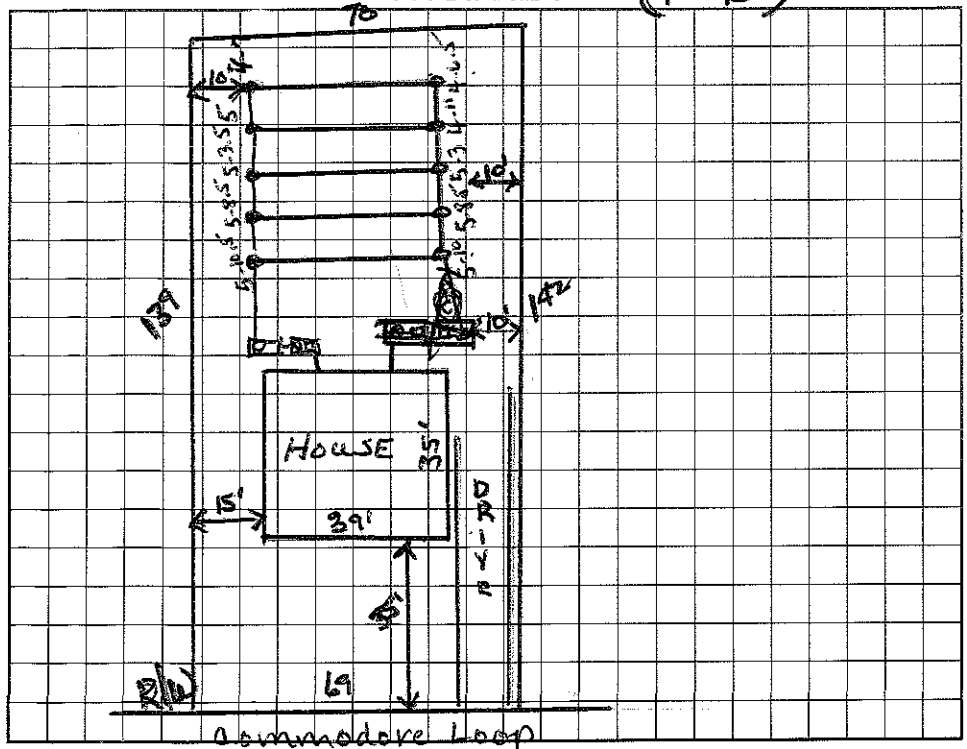

AS BUILT SKETCH

I understand that this permit can be suspended or revoked if any false information is supplied toward securing the permit/any unauthorized changes are made to the site/any unauthorized changes are made in the installation of the system. Improvement Permit with plat valid without expiration. Improvement Permit with site plan valid for sixty months. Authorization to Construct is valid for a period equal to that of Improvement Permit – not to exceed sixty months.

Signed: [signature] date 8-24-98 Installed by: Maclaod

Improvement Permit by: Wesley Sparks RS. date 8/20/98 Operation Permit by: Wesley Sparks RS. date 1/7/99

Authorization to Construct by: Wesley Sparks RS. date 8/20/98 Existing System Inspection by: date

HEALTH DEPT. COPY: WHITE INSPECTION COPY (FINAL): GREEN OWNER COPY (FINAL): YELLOW INSPECTION COPY (INITIAL): PINK OWNER COPY (INITIAL): GOLD