IREDELL COUNTY HEALTH DEPARTMENT

Authorization to Construct

STATESVILLE 704-878-5305 MOORESVILLE 704-664-5281

IMPROVEMENT PERMIT / ~~CERTIFICATE OF COMPLETION~~ / OPERATION PERMIT / EXISTING SYSTEM INSPECTION

PROPERTY DESCRIPTION NO. 070621 DATE 12/8/97 TAX MAP NO. 4635794619 Watershed: ☒ Yes ☐ No

OWNER OR CONTRACTOR ~~PAUL CALLAHAN~~ DUANE LEWIS PHONE: Business 664-3382 Home WSIVCA

ADDRESS PO BOX 1003 MOORESVILLE, NC. 28115

LOCATION 244 COMMODORE Loop; STUTTS TL 2ND COMMODORE LP. ON (L) ~ .5mile 244 Comm. Lp.

SUBDIVISION COMMODORE PH I BLOCK / SECTION ____ LOT 173 LOT AREA .22AC SITE CLASS. PS DESIGN FLOW 360 L.T.A.R. .3

Septic Tank: 1000 Gallons; STB 794 Date 8-14-98

Pump Tank: 1000 Gallons; PT 27 Date 10/10/98

Pump Make: HYDROMATIC Model SK50A1 Serial No. 2/98

Nitrification Field: No Fields 1 Square Feet ✓ 600 Linear Feet ✓ 200

No Lines 5 Trench Width 36" Max Trench Bottom Depth 36" Gravel Depth SAND

☒ New System ☐ Repair System Type: I, II, (III), IV, V, VI

System Description: ✓ PRESMAN → 16" ABS

Repair System Description: SAME

Maintenance Agreement Required: ☐ Yes ☐ No

☒ House/Mod. Home No. Bedrooms 3

☐ Mobile Home No. Bathrooms 2

☐ Business No. Employees ____

☐ Other ____


☐ Slab ☐ Crawl Space ☐ Basement w/plumbing ☐ Basement wo/plumbing

Water Supply:
☐ Individual
☒ Community
☐ Public


Comments: ✓ 36" WIDTH OF TRENCHES

Comments:

INITIAL SITE SKETCH

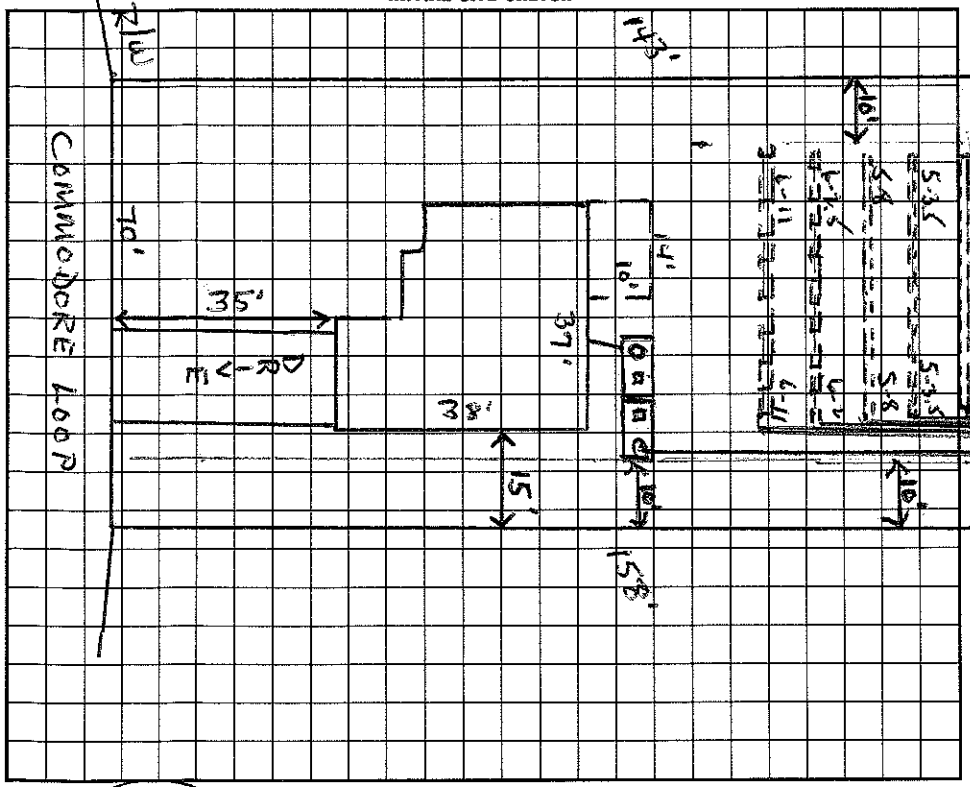

AS BUILT SKETCH

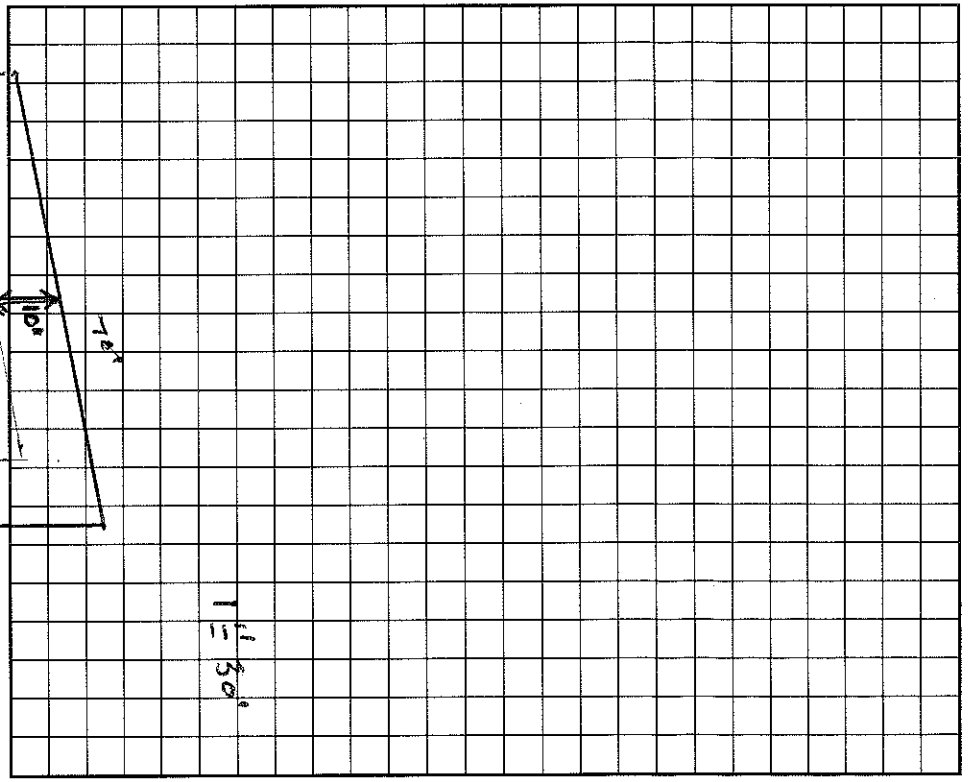

I understand that this permit can be suspended or revoked if any false information is supplied toward securing the permit/any unauthorized changes are made to the site/any unauthorized changes are made in the installation of the system. Improvement Permit is valid for 60 months from date of issuance.

Signed: ✓ Paul T. Callahan

Improvement Permit by: Wesley Sparks R.S. date 12/8/97

~~Existing System Inspection~~ by: Wesley Sparks R.S. date 12/8/97

Installed by: Macleod

Certificate of Completion by: ____ date ____

Operation Permit by: Wesley Sparks R.S. date 1/7/99

HEALTH DEPT. COPY: WHITE INSPECTION COPY (FINAL): GREEN OWNER COPY (FINAL): YELLOW INSPECTION COPY (INITIAL): PINK OWNER COPY (INITIAL): GOLD