IREDELL COUNTY HEALTH DEPARTMENT

Statesville Office (704) 878-5305 Mooresville Office (704) 660-3625 PERMIT # 206885

IMPROVEMENT PERMIT / AUTHORIZATION TO CONSTRUCT / OPERATION PERMIT / EXISTING SYSTEM

PIN # 4635796715

APPLICANT: Leon Radkewitz APPLICANT ADDRESS: 113 Elm Street Wharton NJ

SITE ADDRESS: 230 Commodore LP PHONE: 973-727-0803 ALT. PHONE: N/A

SITE DIRECTIONS: BSR TL Stutts Rd. TL Commodore LP

SUBDIVISION: Commodore Peninsula SECTION: N/A LOT # 176 LOT AREA: 0.23acres DESIGN FLOW: 360gpd L.T.A.R.: Existing

Septic Tank Existing (gal) STB Date

Pump Tank (gal) PT Date

Pump Make Model Serial #

Nitrification Fields Ex # Lines 6x Linear Ft: 6x

Trench Width 6x Max. Trench Bottom Depth 6x Gravel Depth 6x

☐ New System ☐ Repair ☐ Expansion System Type: I ☑ II III IV V VI

System Description: Conventional Bed

Repair System Description:

Maintenance Agreement Required: ☐ YES ☑ NO

☑ GRAVITY ☐ PRESSURE

☑ Residence No. Bedrooms 3

☐ Business No. Persons 6

☐ Other No. Employees

☐ Slab ☑ Crawl Space


☐ Basement w/plumbing ☐ Basement w/o plumbing

Water Supply: ☐ Private ☐ Public ☑ Community


Comments / Conditions:

- Maintain a minimum of 5' between accessory building foundation & all components of septic tank system.

INITIAL SITE SKETCH

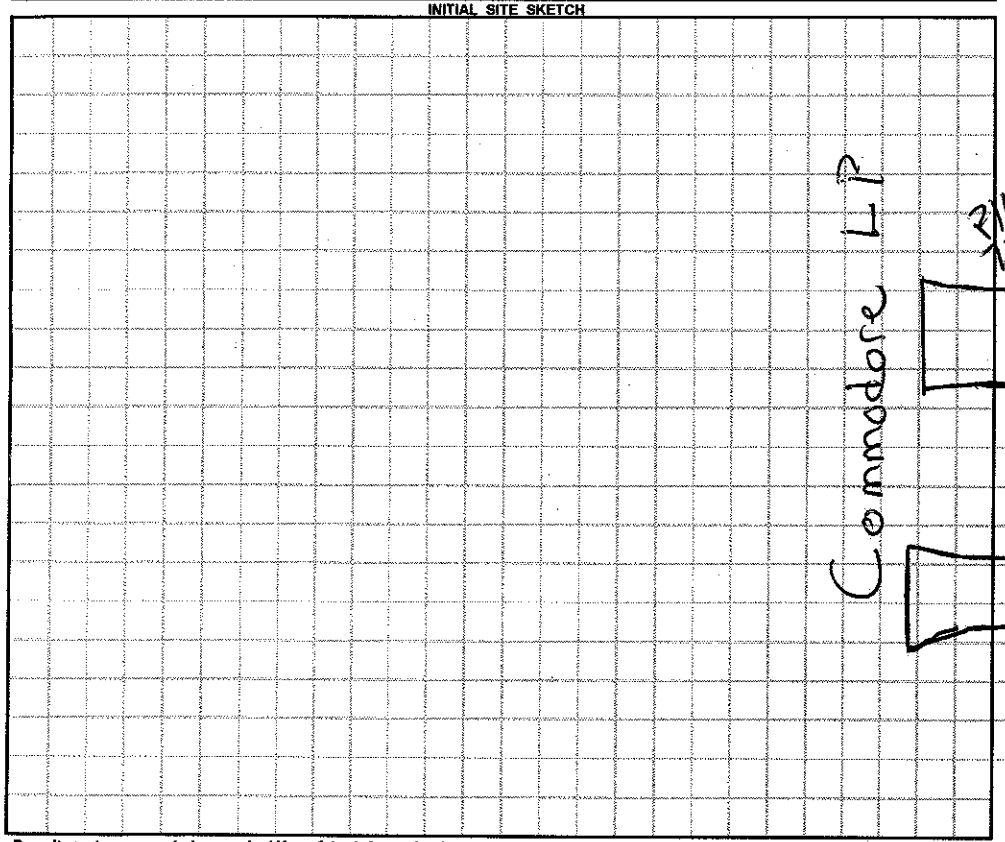

AS BUILT SKETCH

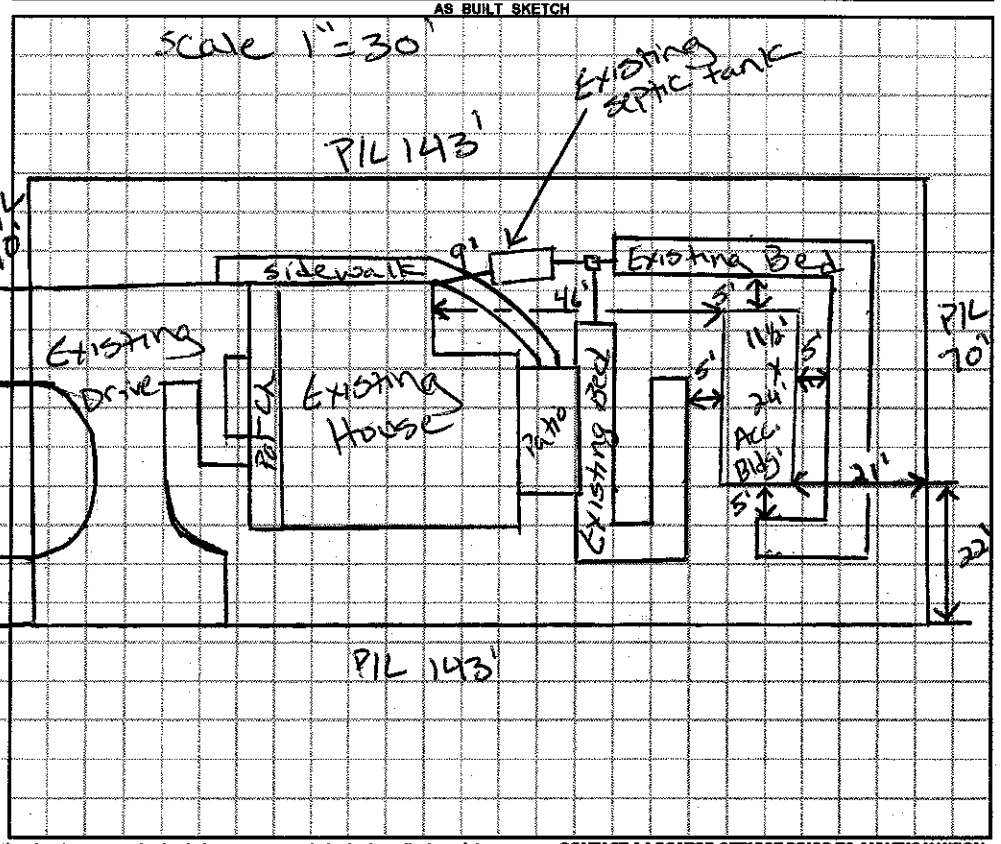

Permit can be suspended or revoked if any false information is supplied toward securing the permit / any unauthorized changes are made to the site / any unauthorized changes are made in the installation of the system. **CONTACT A LOCATOR SERVICE PRIOR TO ANY EXCAVATION**

☐ **IMPROVEMENT PERMIT** *with plat valid without expiration.* ☐ **IMPROVEMENT PERMIT** *with site plan valid for 60 mos.* ☐ **AUTHORIZATION TO CONSTRUCT** *valid for period equal to IMPROVEMENT PERMIT--not to exceed 60 mo.*

Owner / Applicant Signature: Date: 11/23/14 Installed by:

IMPROVEMENT PERMIT by: Date: OPERATION PERMIT by: Date:

AUTHORIZATION TO CONSTRUCT by: Date: Existing System Inspected by: Justin Rhinehardt Date: 12-22-14

Health Dept. Copy - WHITE Applicant (Final Approval) - YELLOW Applicant (Conditional Approval) - PINK