IREDELL COUNTY HEALTH DEPARTMENT

STATESVILLE 704-878-5305 MOORESVILLE 704-664-5281

IMPROVEMENT PERMIT / CERTIFICATE OF COMPLETION / OPERATION PERMIT / EXISTING SYSTEM INSPECTION

PROPERTY DESCRIPTION NO. REPAIR DATE 3/5/97 TAX MAP NO. REPAIR Watershed: ☐ Yes ☐ No

OWNER OR CONTRACTOR F.O. HOWARD PHONE: Business _____ Home 704-483-3023

ADDRESS 221 COMMODORE LOOP

LOCATION BRAWLEY SCHOOL - TL STUTTS RD - TL COMMODORE LOOP - 221 COMMODORE ON LEFT.

SUBDIVISION COMMODORE LOOP BLOCK / SECTION — LOT — LOT AREA — SITE CLASS. RS DESIGN FLOW 360 GPD L.T.A.R. —

Septic Tank: 1000 Gallons; STB 525 Date 4/2/97

Pump Tank: _____ Gallons; PT _____ Date _____

Pump Make: _____ Model _____ Serial No. _____

Nitrification Field: No Fields 1 Square Feet 540 Linear Feet 180

No Lines 1 BED Trench Width 9' Max Trench Bottom Depth AS NEEDED Gravel Depth SAND

☑ New System ☑ Repair System Type: I, II, III, IV, V, VI

System Description: _____

Repair System Description: GRAVITY CHAMBERED

Maintenance Agreement Required: ☐ Yes ☑ No BED

☑ House/Mod. Home No. Bedrooms 3

☐ Mobile Home No. Bathrooms 2

☐ Business No. Employees _____

☐ Other _____


☐ Slab ☑ Crawl Space ☐ Basement w/plumbing ☐ Basement wo/plumbing

Water Supply: ☐ Individual ☑ Community ☐ Public


Comments:

Comments:

INITIAL SITE SKETCH

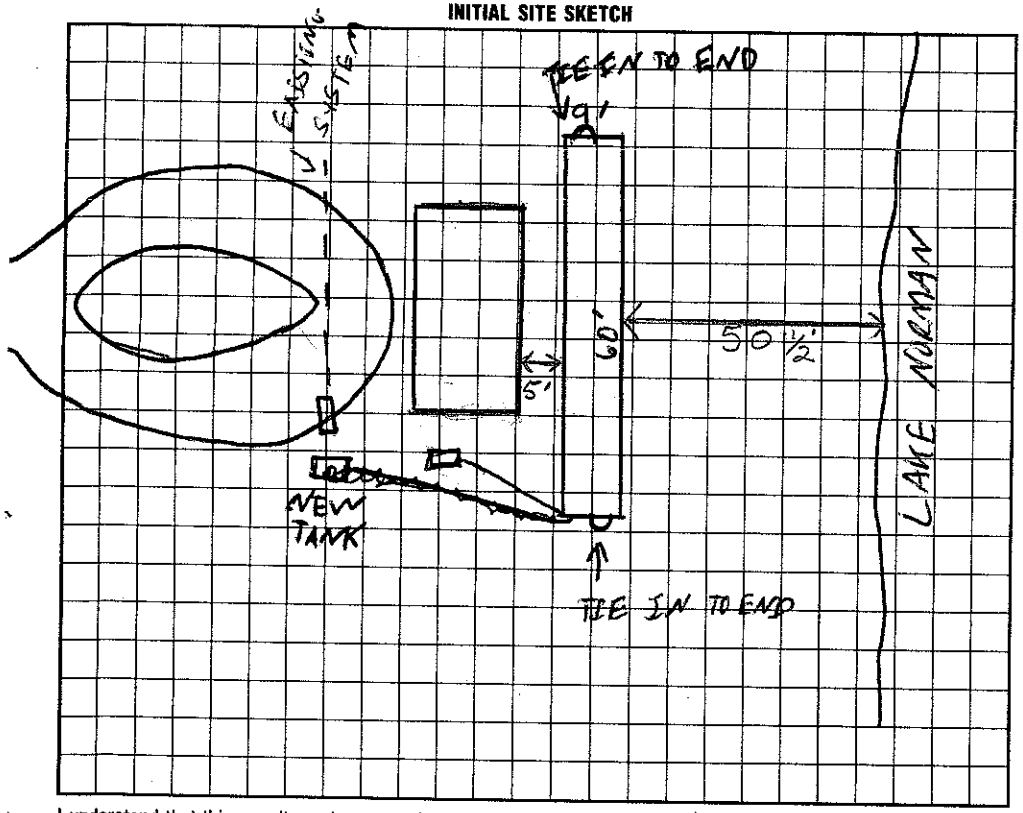

AS BUILT SKETCH

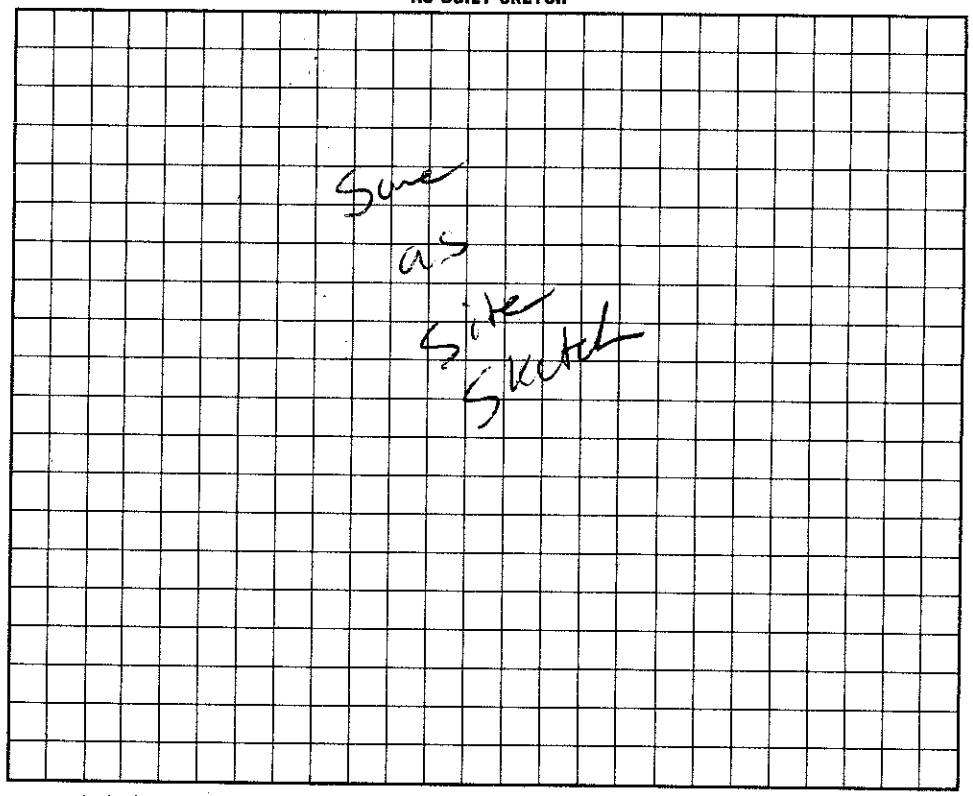

I understand that this permit can be suspended or revoked if any false information is supplied toward securing the permit/any unauthorized changes are made to the site/any unauthorized changes are made in the installation of the system. Improvement Permit is valid for 60 months from date of issuance.

Signed: Melba Howard

Improvement Permit by: C. Ray Zoeller date 3/5/97

Existing System Inspection by: C. Ray Zoeller date 3/5/97

Installed by: WAYNE KLONTZ

Certificate of Completion by: _____ date _____

Operation Permit by: C. Ray Zoeller date 5/14/97

HEALTH DEPT. COPY: WHITE INSPECTION COPY (FINAL): GREEN OWNER COPY (FINAL): YELLOW INSPECTION COPY (INITIAL): PINK OWNER COPY (INITIAL): GOLD