IREDELL COUNTY HEALTH DEPARTMENT

Statesville Phone TR 3-7271 Mooresville Phone No. 664-5281

PERMIT TO INSTALL SEPTIC TANK

Permit No. 35 Permit Date 3 - 19 - 1973

Owner Carl Lawson Address Mooresville

Installed By Sam Oswalt Address Troutman


Location of Property Lakeview Shores 14 C

Tank		Capacity		Length of Lines		Fixtures	
Block	( )	1000	(✓)	225'	( )	No. of Baths	(3)
Precast	(✓)	1250	( )	250'	( )	Dishwasher	(yes)
		1500	( )	Other 300'		Garbage Grdr.	(no)
		Other				Other Washing machine	

NOTIFY HEALTH DEPARTMENT AT LEAST EIGHT HOURS BEFORE TANK IS TO BE INSPECTED.

Final Inspection 3 - 19 - 1973 Approved ( ) Disapprcved ( )

Remarks Lot has severe drainage problem — system approved on construction. Drainage ditch was installed to try to improve drainage.

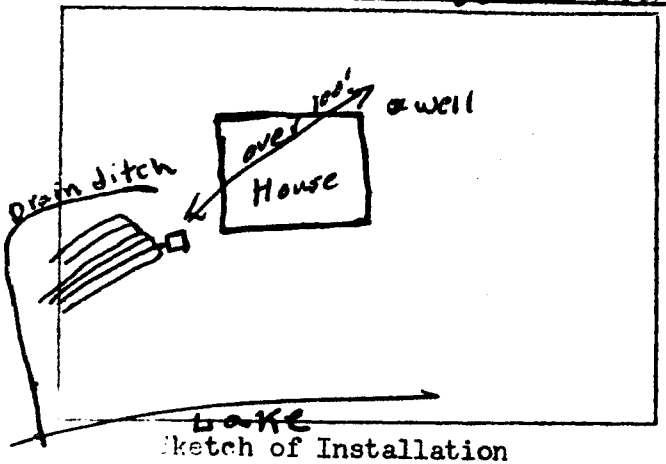

Sketch of Installation

J. C. Moore

Sanitarian