IREDELL COUNTY HEALTH DEPARTMENT

STATESVILLE 704-878-5305 MOORESVILLE 704-664-5281

IMPROVEMENT PERMIT / CERTIFICATE OF COMPLETION / OPERATION PERMIT / EXISTING SYSTEM INSPECTION

PROPERTY DESCRIPTION NO. 20663 DATE 5/22/95 TAX MAP NO. 2KB 27 Pt. Watershed: [X] Yes [ ] No

OWNER OR CONTRACTOR Genesis Developers LTD. PHONE: Business 498-2952 ~~Home~~ 4635-80-3172

ADDRESS PO Box 44 Stanley Ford, NC. 28673

LOCATION Shoreview Dr. (R) off Sundown Rd. to cul de sac enter (R) off cul de sac

SUBDIVISION LAKE VISTA BLOCK / SECTION 1 LOT 6 LOT AREA ~1.0 AC SITE CLASS. P DESIGN FLOW 480 L.T.A.R. .35

Septic Tank: 1000 Gallons; STB ____ Date ____

Pump Tank: ____ Gallons; PT ____ Date ____

Pump Make: ____ Model ____ Serial No. ____

Nitrification Field: No Fields 1 Square Feet 1371 Linear Feet *228 (457)

No Lines 4 Trench Width 24" Max Trench Bottom Depth 33" Gravel Depth 6" SAND

[X] New System [ ] Repair System Type: I, II, [III], IV, V, VI

System Description: GRAVITY PANEL

Repair System Description: PRESSURE PANEL

Maintenance Agreement Required: [ ] Yes [ ] No

[X] House/Mod. Home No. Bedrooms 4

[ ] Mobile Home No. Bathrooms 3

[ ] Business No. Employees ____

[ ] Other ____


[ ] Slab [X] Crawl Space [ ] Basement w/plumbing [ ] Basement wo/plumbing

Water Supply: [X] Individual [ ] Community [ ] Public

Comments: * 50% reduction for 16" Panel Blocks

Comments: Installed as drawn -

INITIAL SITE SKETCH

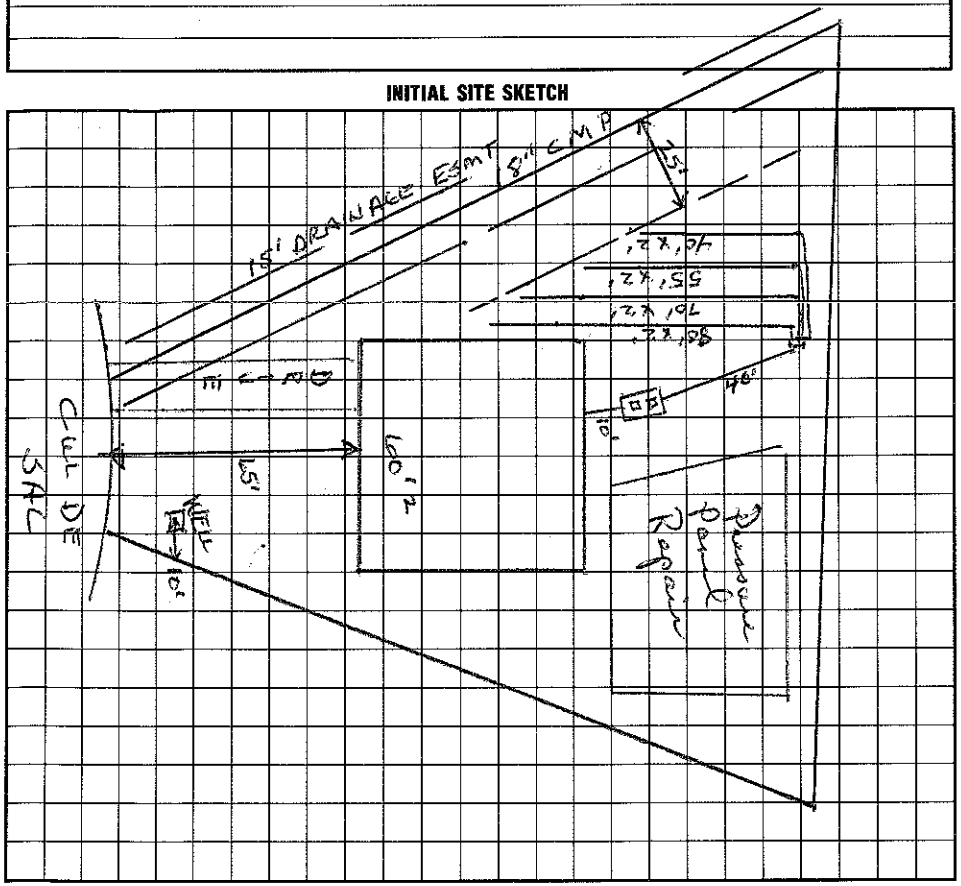

AS BUILT SKETCH

I understand that this permit can be suspended or revoked if any false information is supplied toward securing the permit/any unauthorized changes are made to the site/any unauthorized changes are made in the installation of the system. Improvement Permit is valid for 60 months from date of issuance.

Signed: [signature]

Improvement Permit by: Wesley Sparks RS. date 5/22/95

Existing System Inspection by: ____ date ____

Installed by: Iron Horse Grading

Certificate of Completion by: Wesley Sparks RS date 6/4/97

Operation Permit by: Wesley Sparks RS date 6/4/97

HEALTH DEPT. COPY: WHITE INSPECTION COPY (FINAL): GREEN OWNER COPY (FINAL): YELLOW INSPECTION COPY (INITIAL): PINK OWNER COPY (INITIAL): GOLD