IREDELL COUNTY HEALTH DEPARTMENT

Auth. to Construct

STATESVILLE 704-878-5305 MOORESVILLE 704-664-5281

IMPROVEMENT PERMIT / ~~CERTIFICATE OF COMPLETION~~ / OPERATION PERMIT / EXISTING SYSTEM INSPECTION

PROPERTY DESCRIPTION NO. 23674 DATE 7/2/96 TAX MAP NO. 2B 1C 25 Watershed: [X] Yes [ ] No

OWNER OR CONTRACTOR Robert Jenkins ~~PHONE: Business~~ 4635-80-5423 Home 543-4747

ADDRESS 5801 Ryder Ave Charlotte, NC. 28225

LOCATION Langtree TR Lakeshore Lp. TL Aqua Dr. to 8th lot on (L)

SUBDIVISION Lakeview Shores BLOCK / SECTION _____ LOT 25 LOT AREA ~25000 SITE CLASS. PS DESIGN FLOW 360 L.T.A.R. .3

Septic Tank: 1000 Gallons; STB 1017 Date 5/24/96
Pump Tank: _____ Gallons; PT _____ Date _____
Pump Make: _____ Model _____ Serial No. _____
Nitrification Field: No Fields 1 Square Feet 1200 Linear Feet ~~300~~
No Lines 4 Trench Width 36" Max Trench Bottom Depth 36" Gravel Depth SAND

[X] New System [ ] Repair System Type: I, II, (III), IV, V, VI
System Description: ~~Ch~~ PLASTIC
Repair System Description: SAME
Maintenance Agreement Required: [ ] Yes [X] No


[X] House/Mod. Home No. Bedrooms 3
[ ] Mobile Home No. Bathrooms 2.5
[ ] Business No. Employees ____
[ ] Other _____
[ ] Slab [X] Crawl Space [ ] Basement w/plumbing [ ] Basement wo/plumbing

Water Supply: [X] Individual [ ] Community [ ] Public

Comments: Trenches will begin deeper than shallow up-running with slope -

Comments:

INITIAL SITE SKETCH

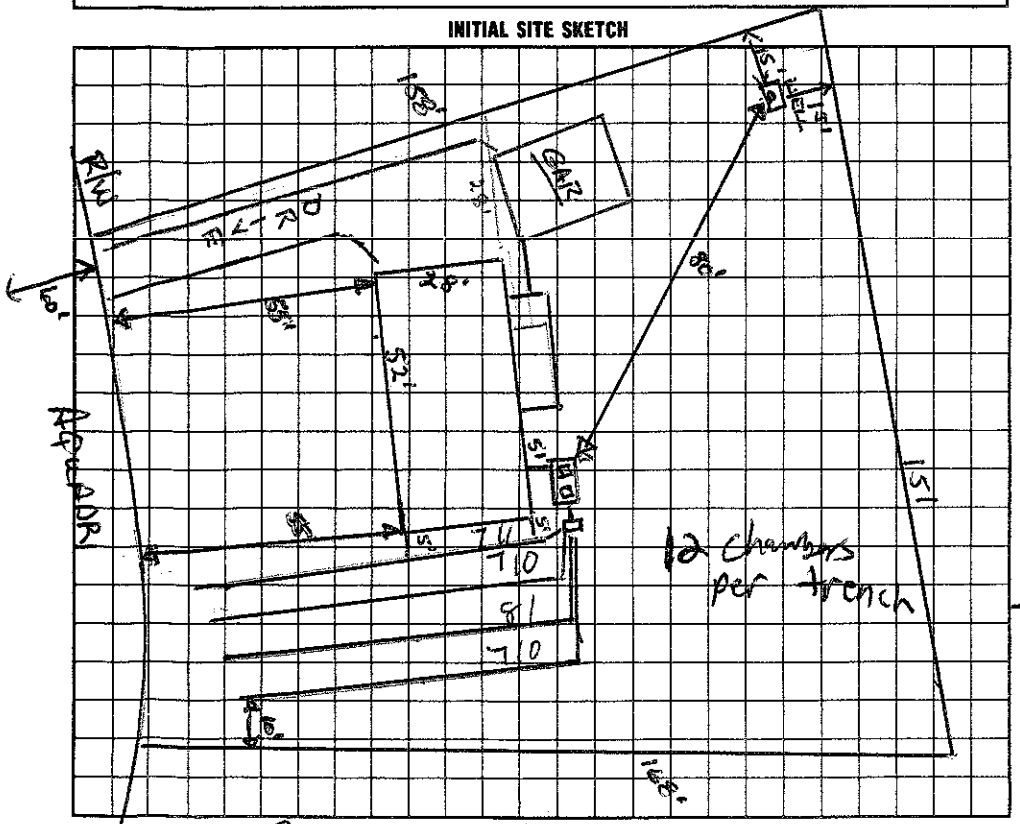

AS BUILT SKETCH

I understand that this permit can be suspended or revoked if any false information is supplied toward securing the permit/any unauthorized changes are made to the site/any unauthorized changes are made in the installation of the system.

Signed: ~~Robert~~ C. Jenkins

Improvement Permit by: Wesley Sparks R.S. date 7/2/96

Existing System Inspection by: Wesley Sparks R.S. date 7/2/96.

Installed by: Richard Abernathy

Certificate of Completion by: _____ date _____

Operation Permit by: C. [illegible] EH SP date 8/21/96

HEALTH DEPT. COPY: WHITE INSPECTION COPY (FINAL): GREEN OWNER COPY (FINAL): YELLOW INSPECTION COPY (INITIAL): PINK OWNER COPY (INITIAL): GOLD