9:30 - 10:00

IREDELL COUNTY HEALTH DEPARTMENT

STATESVILLE 704-878-5305 MOORESVILLE 704-664-5281

IMPROVEMENT PERMIT / AUTHORIZATION TO CONSTRUCT / OPERATION PERMIT / EXISTING SYSTEM INSPECTION

PERMIT# 20687 PIN# 2K B 27 Pt of. 4635-80-6449 DATE 4/1/99

OWNER OR CONTRACTOR Richardson Homes PHONE: Business 704-843-4637 Home

ADDRESS 4724 Parkwood Sch. Rd. Monroe, NC. 28112

LOCATION Sundown Rd. on (R) past Shoreview Dr.

SUBDIVISION LAKE VISTA BLOCK / SECTION LOT 24 LOT AREA 1.63Ac SITE CLASS. PS DESIGN FLOW ~~360~~ 360 Ausz L.T.A.R. .3

Septic Tank: 1000 Gallons; STB 794 Date 4-24-99
Pump Tank: Gallons; PT Date
Pump Make: Model Serial No.
Nitrification Field: No Fields 1 Square Feet 1200 Linear Feet 400
No Lines 4 Trench Width 36" Max Trench Bottom Depth 36" Gravel Depth 12"

[X] New System [ ] Repair System Type: I, (II), III, IV, V, VI
System Description: Gravity-Conventional
Repair System Description: Pressure-Type II
Maintenance Agreement Required: [ ] Yes [X] No


[X] House/Mod. Home No. Bedrooms 3
[ ] Mobile Home No. Bathrooms 3
[ ] Business No. Employees
[ ] Other
[ ] Slab [X] Crawl Space [ ] Basement w/plumbing [ ] Basement wo/plumbing

Water Supply: [X] Individual [ ] Public [ ] Community


Comments/Conditions: Filter & riser installed

Comments/Conditions:

INITIAL SITE SKETCH

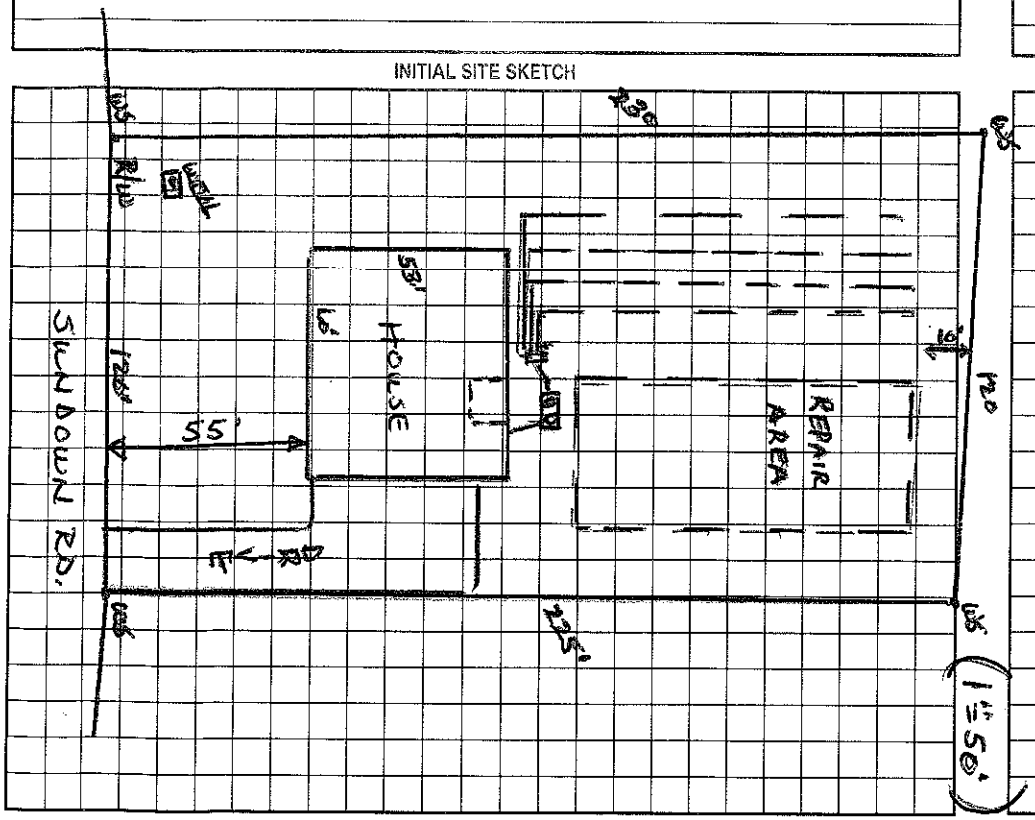

AS BUILT SKETCH

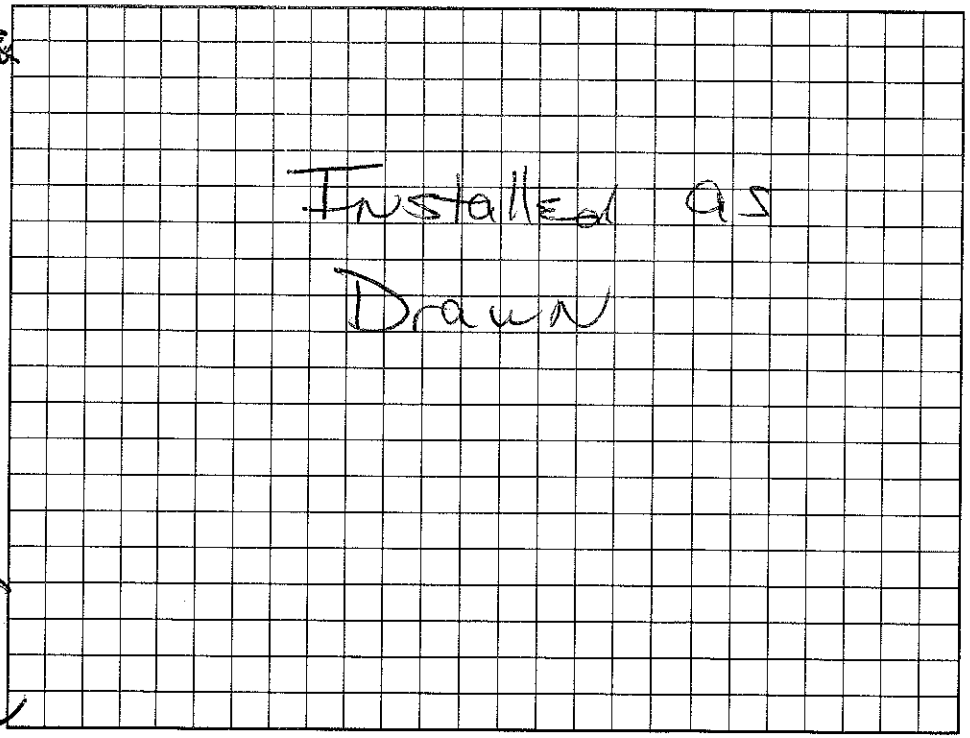

Permit can be suspended or revoked if any false information is supplied toward securing the permit/any unauthorized changes are made to the site/any unauthorized changes are made in the installation of the system. Improvement Permit with plat valid without expiration. Improvement Permit with site plan valid for sixty months. Authorization to Construct is valid for a period equal to that of Improvement Permit – not to exceed sixty months.

Signed: * J.A. McNeill date 4/6/99

Improvement Permit by: Wesley Sparks RS. date 4/1/99

Authorization to Construct by: Wesley Sparks RS. date 4/1/99

Installed by: Curt Dunning

Operation Permit by: Maria H. Watson R.S. date 8/11/99

Existing System Inspection by: date

HEALTH DEPT. COPY: WHITE OWNER COPY (FINAL): YELLOW OWNER COPY (INITIAL): PINK