IREDELL COUNTY HEALTH DEPARTMENT

STATESVILLE 704-878-5305 MOORESVILLE 704-664-5281

3:00

IMPROVEMENT PERMIT / AUTHORIZATION TO CONSTRUCT / OPERATION PERMIT / EXISTING SYSTEM INSPECTION

PERMIT# 71548 PIN# 4635807555 DATE 12/6/99

OWNER OR CONTRACTOR DAVID REYNOLDS PHONE: Business 895-2340 Home

ADDRESS 16843 VINEYARD POINT LN COVELLENS NC 28031

LOCATION LAKETREE - TR LAKESHORE - TL AQUA - ON LT

SUBDIVISION LAKEVIEW SHORES BLOCK / SECTION LOT 23 LOT AREA SITE CLASS. PS DESIGN FLOW 360 GPD L.T.A.R. .30 GPD/FT²

Septic Tank: 1000 Gallons; STB 312 Date 2-29-00
Pump Tank: Gallons; PT Date
Pump Make: Model Serial No.
Nitrification Field: No Fields 1 Square Feet 900 Linear Feet 300
No Lines 3 @ 100' Trench Width 36" Max Trench Bottom Depth 36" Gravel Depth N/A

☑ New System ☐ Repair System Type: I, II, III, IV, V, VI
System Description: GRAVITY 25% REDUCTION
Repair System Description: DEED B-4 1983
Maintenance Agreement Required: ☐ Yes ☑ No

☑ House/Mod. Home No. Bedrooms 3
☐ Mobile Home No. Bathrooms 2.5
☐ Business No. Employees
☐ Other
☑ Slab ☑ Crawl Space ☐ Basement w/plumbing ☐ Basement wo/plumbing


Water Supply: ☑ Individual ☐ Public ☐ Community

Comments:/Conditions:


- REVISED -

Comments:/Conditions:

INITIAL SITE SKETCH 1"=40'

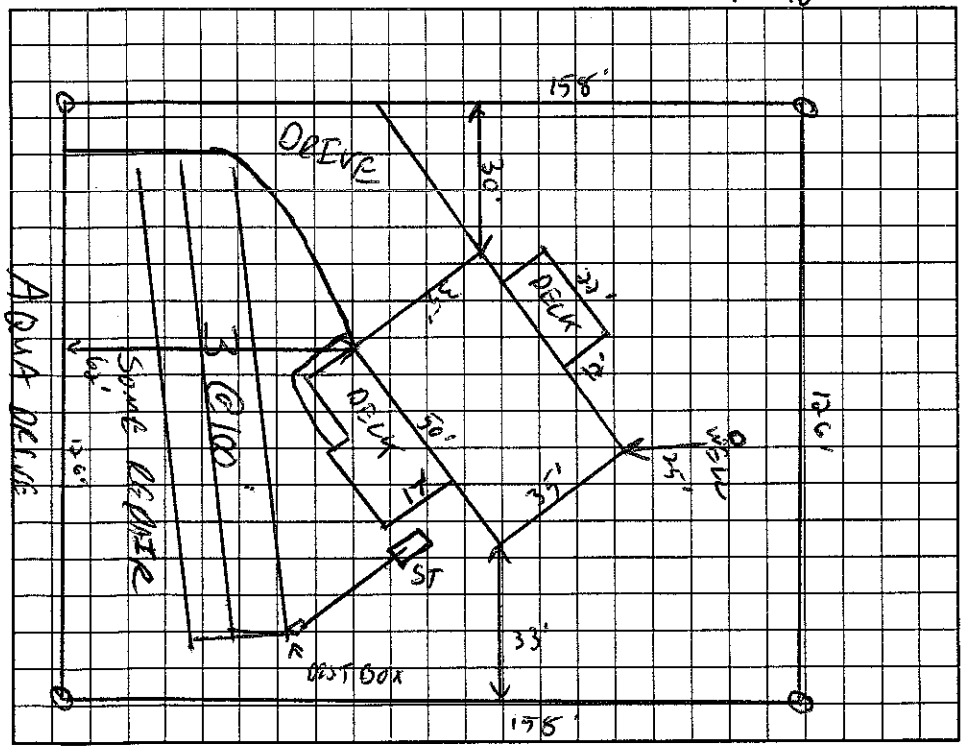

AS BUILT SKETCH

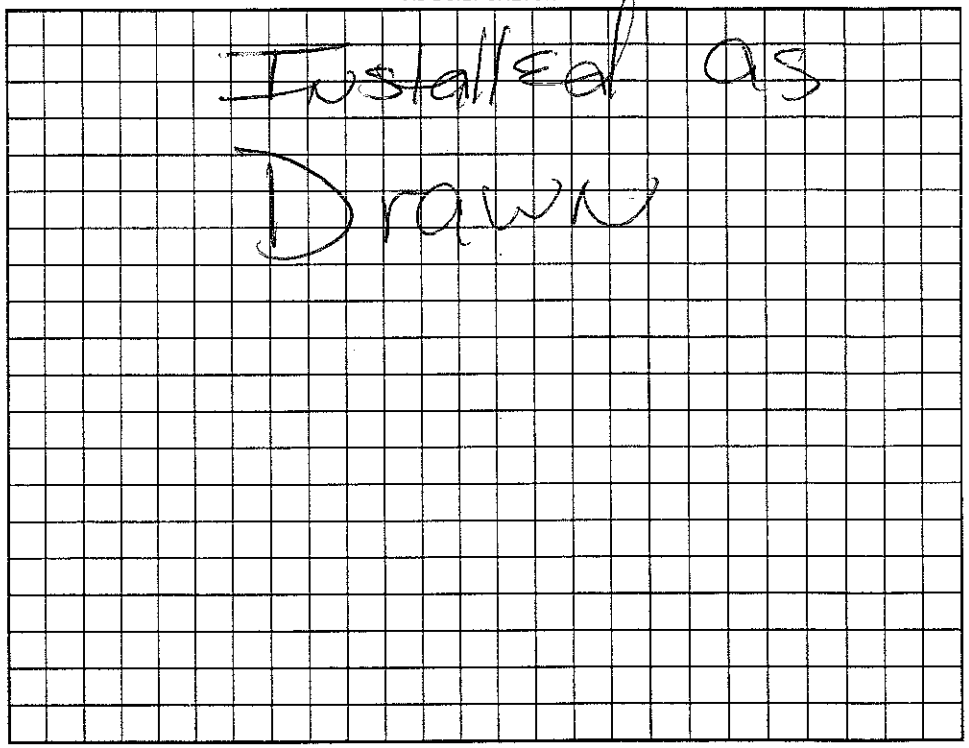

Permit can be suspended or revoked if any false information is supplied toward securing the permit/any unauthorized changes are made to the site/any unauthorized changes are made in the installation of the system. Improvement Permit with plat valid without expiration. Improvement Permit with site plan valid for sixty months. Authorization to Construct is valid for a period equal to that of Improvement Permit – not to exceed sixty months.

Signed: (David V. Reynolds) date 12/16/99

Improvement Permit by: ES date 12/6/99

Authorization to Construct by: ES date 12/16/99

Installed by: Curt Dunning RS

Operation Permit by: RS date 5/5/2000

Existing System Inspection by: date

HEALTH DEPT. COPY: WHITE OWNER COPY (FINAL): YELLOW OWNER COPY (INITIAL): PINK