4635807726

IREDELL COUNTY HEALTH DEPARTMENT

STATESVILLE 704-878-5305 MOORESVILLE 704-664-5281

IMPROVEMENT PERMIT / CERTIFICATE OF COMPLETION / OPERATION PERMIT / EXISTING SYSTEM INSPEC

PROPERTY DESCRIPTION NO. 20084 DATE Jan 30 '95 TAX MAP NO. 2B1B3 Watershed: ☑ Yes ☐ No CW WSIV

OWNER OR CONTRACTOR Jemmy N. Mosier PHONE: ~~Business~~ 704-79-7906 Home

ADDRESS Apt N 10124 Plum Creek Lane Charlotte NC 28210

LOCATION 115 S TR Langtree Rd. TR Lakeshore Dr. TL Aqua Dr. on Right

SUBDIVISION Lakeview Shores BLOCK / SECTION LOT 3 LOT AREA 20,000 ft² SITE CLASS PS per 1956 DESIGN FLOW 360 gpd L.T.A.R. .7

Septic Tank: 1000 Gallons; STB 794 Dellinger Date 6-29-95

Pump Tank: Gallons; PT Date

Pump Make: Model Serial No.

Nitrification Field: No Fields 1 Square Feet 900 Linear Feet 300

No Lines 5 Trench Width 36" Max Trench Bottom Depth 36" Gravel Depth N/A

☑ New System ☐ Repair System Type: I, II, III, IV, V, VI

System Description: GRAVITY INFILTRATOR

Repair System Description: LPPPBPS

Maintenance Agreement Required: ☐ Yes ☑ No initially only

☑ House/Mod. Home No. Bedrooms 3

☐ Mobile Home No. Bathrooms 2

☐ Business No. Employees

☐ Other

☐ Slab ☑ Crawl Space ☐ Basement w/plumbing ☐ Basement wo/plumbing

Water Supply: ☑ Individual ☐ Community ☐ Public


Comments: CONTRACTOR NOTE these LATERALS ARE INFILTRATOR Chamber units.

This LOT WAS Recorded prior to 1983


Comments: 5T contractor installed wrong system type initially 8'8" panel added to give required total footage

1" = 50'

INITIAL SITE SKETCH

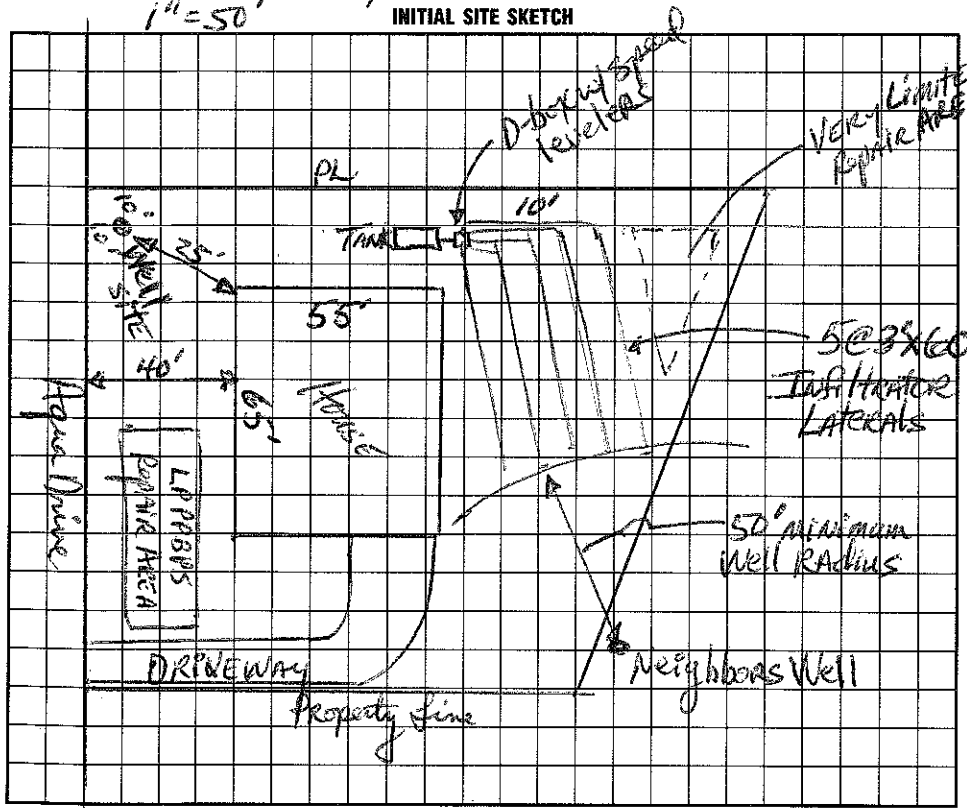

AS BUILT SKETCH

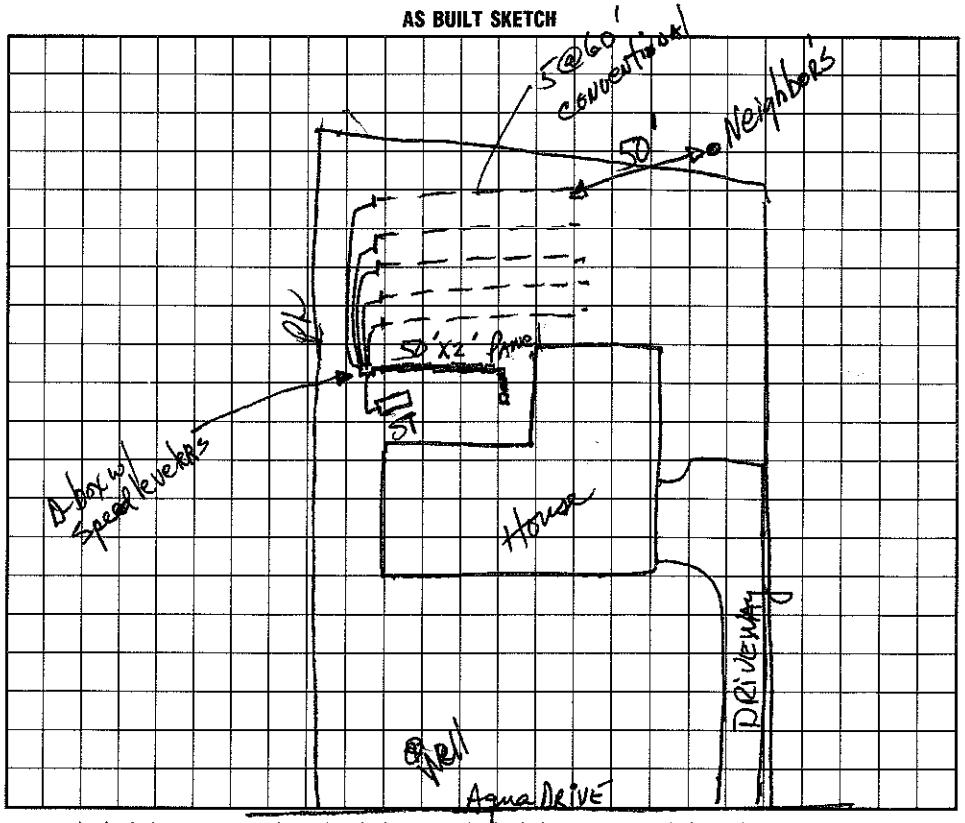

I understand that this permit can be ~~suspended or revoked~~ if any false information is supplied toward securing the permit/any unauthorized changes are made to the site/any unauthorized changes are made in the installation of the system. Improvement Permit is valid for 60 months from date of issuance.

Signed:

Improvement Permit by: date Jan 30 '95

Existing System Inspection by: date

Installed by: A. Cornelius Grading

Certificate of Completion by: date

Operation Permit by: date 9-28-95

HEALTH DEPT. COPY: WHITE INSPECTION COPY (FINAL): GREEN OWNER COPY (FINAL): YELLOW INSPECTION COPY (INITIAL): PINK OWNER COPY (INITIAL): GOLD