IREDELL COUNTY HEALTH DEPARTMENT - *ENVIRONMENTAL HEALTH* ☐ STATESVILLE OFFICE 704-878-5305 ☒ MOORESVILLE OFFICE 704-664-5281

IMPROVEMENT PERMIT / AUTHORIZATION TO CONSTRUCT / OPERATION PERMIT / EXISTING SYSTEM INSPECTION

PERMIT # ~~4645 to~~ 20270 PIN # 4635 80 8652 DATE April 26, 2012

OWNER ~~Cindy Garris~~ Julie Turbeville APPLICANT: Julie Turbeville PHONE: Home/Cell # 704-892-9119 Business # 704-936-1695

SITE ADDRESS 129 Aqua Dr OWNER / APPLICANT ADDRESS 111 Castle Bay Ct. Mooresville 28117

SITE DIRECTIONS 115 S. TR Langtree TR Lakeshore TL Aqua on left

SUBDIVISION Lakeview Shores BLOCK / SECTION A LOT # 22 LOT AREA .41 Ac DESIGN FLOW 480 gpd L.T.A.R. .25 gpd/ft²

Septic Tank 1000 Gallons: STB 760 Date 1-20-13 ☒ New System ☐ Repair ☐ Expansion System Type I II III Ⓘ V VI

Pump Tank 1000 Gallons: PT 363 Date 4-5-14 System Description: LP PPBPS

Pump Make Goulds Model PESTM Serial # Repair System Description: Rule .1945 insufficient space

No. Nitrification Fields: 1 No. Lines 6 Linear Feet 320 Maintenance Agreement Required ☒ YES ☐ NO

Trench Width 24" Max. Trench Bottom Depth 36" Gravel Depth NA ☐ GRAVITY ☒ PRESSURE

☒ Residence No. Bedrooms 4 ☐ Business No. Persons ☐ Other No. Employees ☐ Slab ☒ Crawl Space ☐ Basement w/plumbing ☐ Basement w/o plumbing

Water Supply: ☒ Private ☐ Public ☐ Community

Comments / Conditions: Tight fit on Lot. Shaping required. No pavement shall be placed over system. System line turn-ups shall be accessible for maintenance. Supply line 30" under drive, Sleeved in sch 40 4" pipe, drilled 3/16" hole. Drainlines OK 6/25/14 6/26/14 Tanks checked 50ft from ST to neighbors well

INITIAL SITE SKETCH

See Plan from Kathleen Saunders, LSS
Approved by ICHD
Also Additional Site information dated April 25, 2012

AS BUILT SKETCH

Permit can be suspended or revoked if any false information is supplied toward securing the permit / any unauthorized changes are made to the site / any unauthorized changes are made in the installation of the system.

☐ ***IMPROVEMENT PERMIT*** *with plat valid without expiration.* ☒ ***IMPROVEMENT PERMIT*** *with ~~plat valid without expiration.~~ site plan valid 60 mo.* ☐ ***AUTHORIZATION TO CONSTRUCT*** valid for period equal to IMPROVEMENT PERMIT--not to exceed 60 mo.

Owner / Applicant Signature: Julie Turbeville Date 5/3/12 Installed by: Gunter Grading

IMPROVEMENT PERMIT by: Judy Melville REHS Date 4-26-12 OPERATION PERMIT by: [signature] REHS Date 8-11-14

AUTHORIZATION TO CONSTRUCT by: Judy Melville REHS Date 5-4-12 Existing System Inspected by: REHS Date

YOU SHOULD CONTACT A LOCATOR SERVICE PRIOR TO ANY EXCAVATION

White Copy -- Environmental Health YELLOW COPY (Final) Owner / Applicant PINK COPY (Initial) Owner / Applicant

Survey For:

Julie Turbeville


Date:	04-09-12	Deed Reference: 2073 - 389	Drawn by: W.M.J.
Scale:	1" = 30'	Tax PIN: 4635-80-8652	Job: 201226-2

Lot 22 "Lakeview Shores" P.B. 7, Pg. 47
Davidson Twsp., Iredell Co., N.C.

AMERICAN PLANNING & SURVEYING
559 Bowles Farm Rd.
Statesville, N.C. 28625
Phone (704) 871-9197
Phone (704) 876-3220
Firm License # F-0987

30 0 30 60 90
GRAPHIC SCALE - FEET

For Review Purposes Only

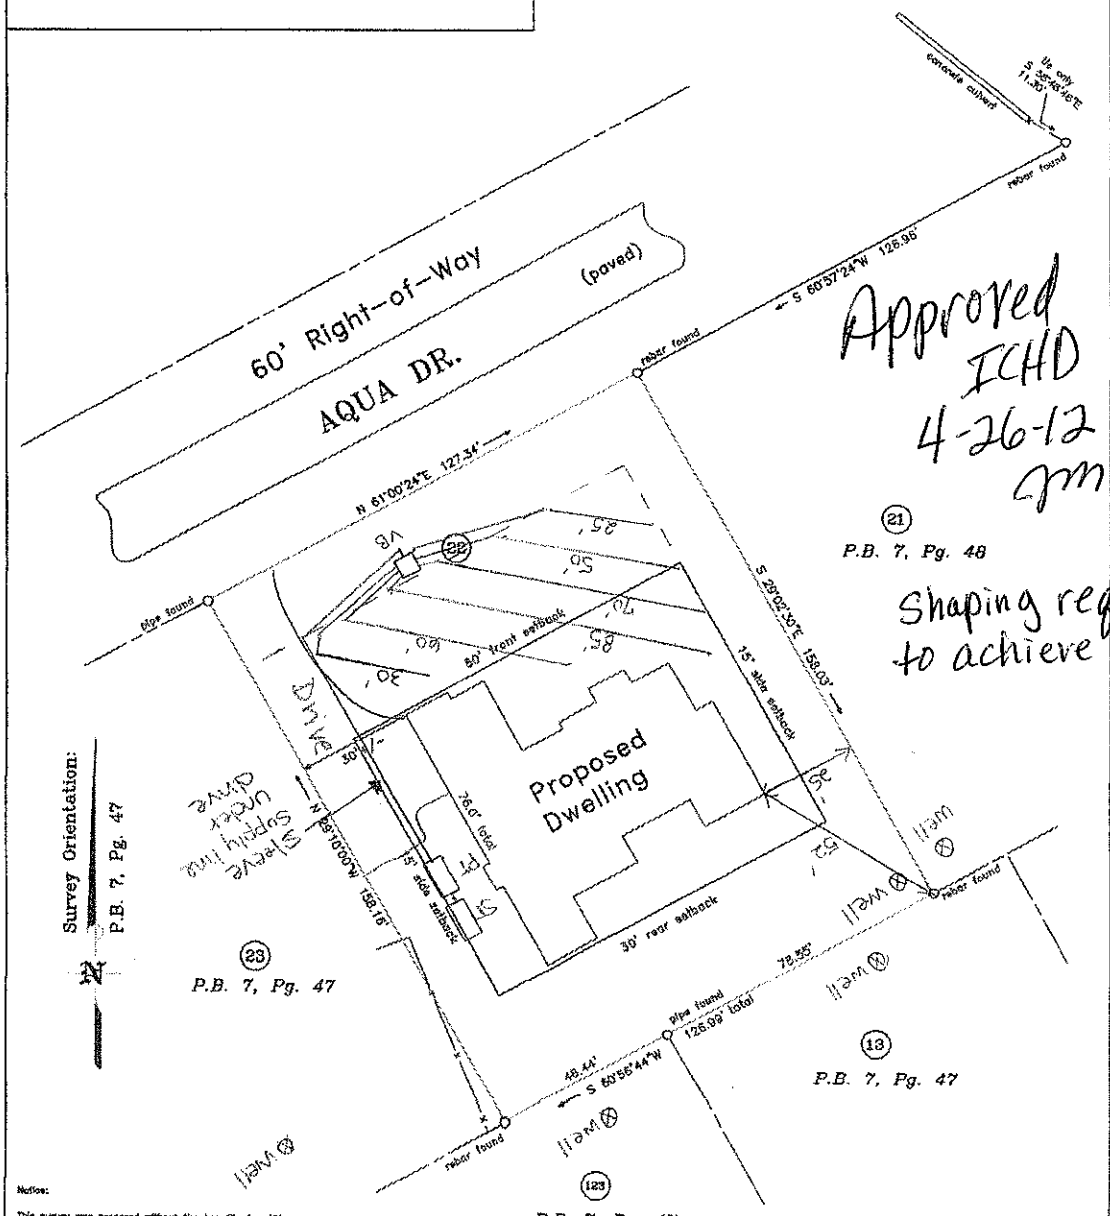

Approved
ICHD
4-26-12
JM

Shaping required to achieve contour

Notice:

This survey was prepared without the benefit of a title abstract and is made subject to any discrepancies which may be disclosed by a thorough and accurate title search.

I, W. Matthew Jordan, Professional Land Surveyor, hereby certify that this plat was drawn under my supervision from an actual survey made under my supervision with a precision ratio of 1: 10,000+.

Witness my seal and signature this April 13th 2012.

For Review Purposes Only

NORTH CAROLINA PROFESSIONAL SEAL L-4414 LAND SURVEYOR MATTHEW JORDAN

W. Matthew Jordan, P.L.S. License #4414

Vicinity Map
(NO SCALE)

