Sketch of Installation

Sanitarian

IREDELL COUNTY HEALTH DEPARTMENT

Statesville Phone TR 3-7271 Mooresville Phone No. 664-5281

PERMIT TO INSTALL SEPTIC TANK

Permit No. 199 Permit Date 8-10- 1973

Owner John R. Sellers owner Carolina Builders Address Charlotte

Installed By orbison Address Mooresville


Location of Property 115 S TR on 1102 to Lakeview Shores 1st 18 C

Tank		Capacity		Length of Lines		Fixtures	
Block	( )	1000	(✓)	225'	(✓)	No. of Baths	(2)
Precast	(✓)	1250	( )	250'	( )	Dishwasher	(yes
		1500	( )	Other		Garbage Grdr.	(no
		Other				Other Washing Machine	

NOTIFY HEALTH DEPARTMENT AT LEAST EIGHT HOURS BEFORE TANK IS TO BE INSPECTED.

Final Inspection 8-10- 1973 Approved ( ) Disapproved ( )

Remarks extra fixtures were added and extra added Square footage was to take care of it. Location prevent going ~~de~~ longer with ditch.

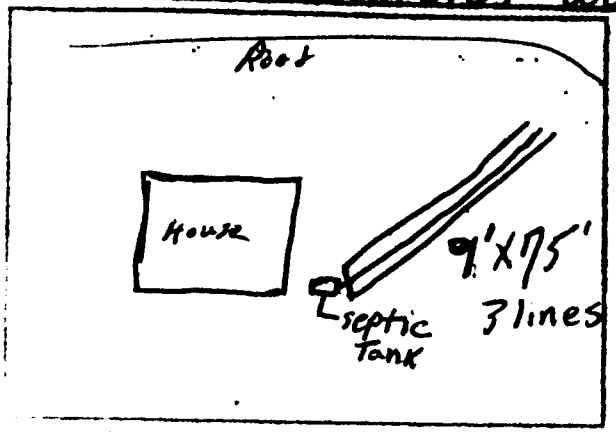

H. C. Moore