IREDELL COUNTY HEALTH DEPARTMENT

STATESVILLE 704-878-5305 MOORESVILLE 704-664-5281

IMPROVEMENT PERMIT / AUTHORIZATION TO CONSTRUCT / OPERATION PERMIT / EXISTING SYSTEM INSPECTION

PERMIT # 153568 PIN # 4635-81-2293 DATE 11-12-08

OWNER or APPLICANT BRAD WATLING PHONE: Business 704-502-9223 Home: 704-892-4205

OWNER or APPLICANT ADDRESS 109 VIEW POINT LN MOORESVILLE NC 28117

LOCATION / DIRECTIONS LANGTREE, TR LAKE SHORE, TR VIEW POINT, 1ST ON L

SUBDIVISION LAKEVIEW SHORES BLOCK / SECTION LOT # 17 LOT AREA .8 AC DESIGN FLOW 360 L.T.A.R. .2

Septic Tank 1000 Gallons: STB 312 Date 8-28-08

Pump Tank 1000 Gallons: PT 27 Date 1-21-08

Pump Make Zoeller Model N152 Serial #

Nitrification Field No Fields No Lines Linear Feet

Trench Width EXISTING Max. Trench Bottom Depth Gravel Depth

☐ New System ☐ Repair ☒ Expansion System Type I II III IV V VI

System Description: LP PANEL BLOCK

Repair System Description: LP PANEL BLOCK

Maintenance Agreement Required ☒ YES ☐ NO

☐ GRAVITY ☒ PRESSURE

☒ Residence No. Bedrooms 3

☐ Business No. Persons

☐ Other No. Employees

☒ Slab ☒ Crawl Space


☒ Basement w/plumbing ☐ Basement w/o plumbing

Water Supply: ☒ Private ☐ Public ☐ Community


Comments / Conditions: 1) INSTALL NEW SEPTIC + PUMP TANK 2) OLD TANKS MUST BE CRUSHED IN + FILLED

Comments / Conditions PRAINFIELD FINE AT TIME OF VISIT Tanks checked 11/20 & 11/21/08 MD BA

INITIAL SITE SKETCH

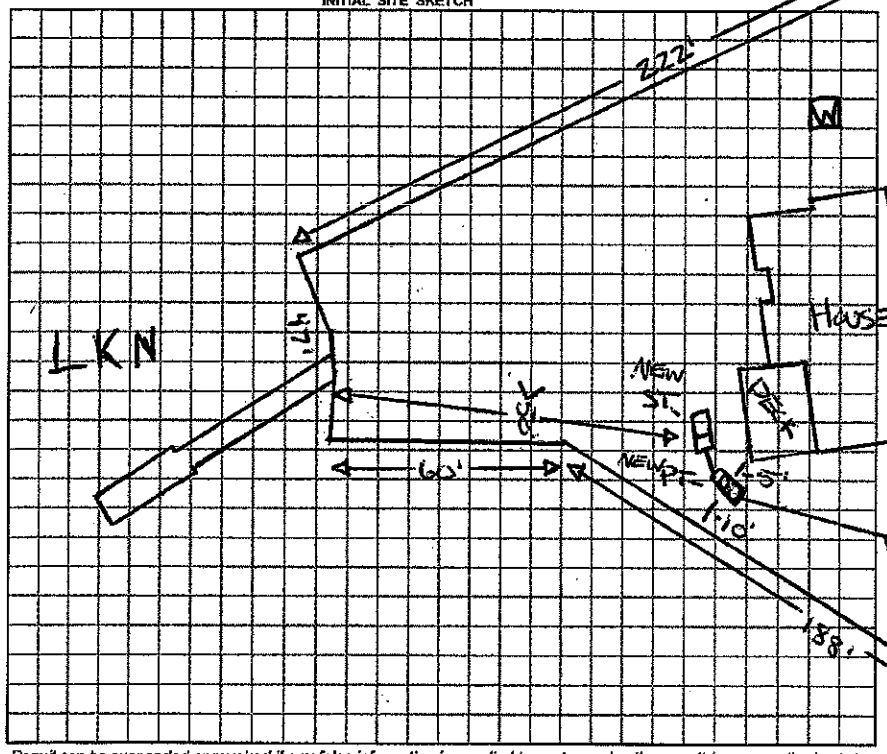

AS BUILT SKETCH

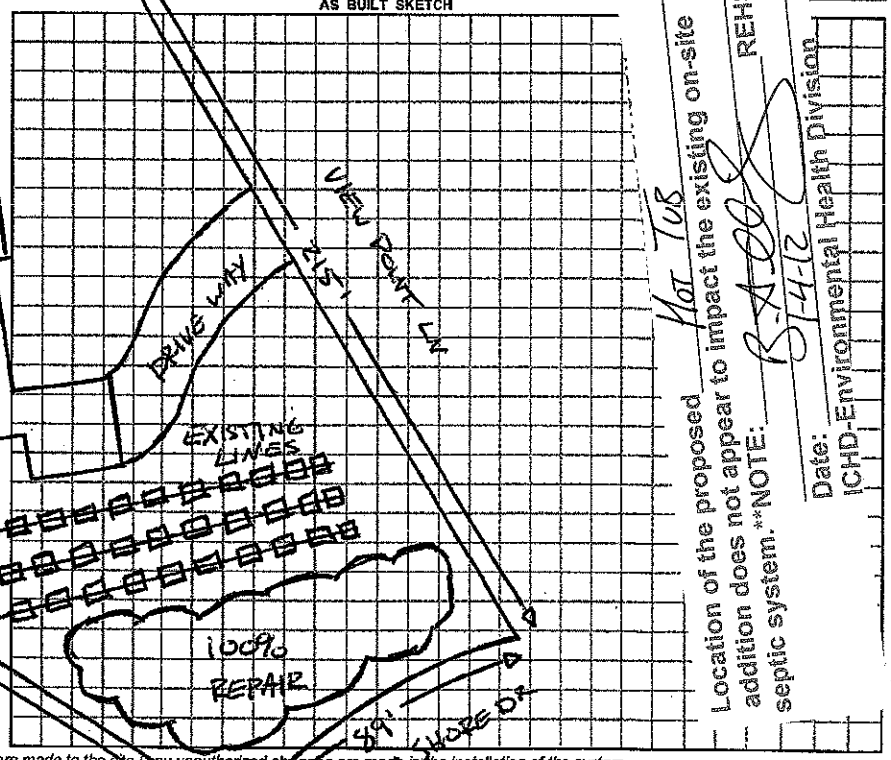




Permit can be suspended or revoked if any false information is supplied toward securing the permit / any unauthorized changes are made to the site / any unauthorized changes are made in the installation of the system.

☐ IMPROVEMENT PERMIT w / plat valid without expiration. ☒ IMPROVEMENT PERMIT w / site plan valid for 60 mos. ☒ AUTHORIZATION TO CONSTRUCT valid for period equal to IMPROVEMENT PERMIT-not to exceed 60 mo.

Owner / Applicant Signature: Date 11/13/08

Improvement Permit by: Date 11-12-08

Authorization to Construct by: Date 11-12-08

YOU SHOULD CONTACT A LOCATOR SERVICE PRIOR TO ANY EXCAVATION.

Installed by: Tim Ammons

Operation Permit by: Date: 1/5/09

Existing System Inspected by: Date:

WHITE COPY Environmental Health YELLOW COPY (Final) Owner / Applicant PINK COPY (Initial) Owner / Applicant

OWNER or APPLICANT BRAD WATLINE PHONE: Business 704-502-9223 Home: 7

OWNER or APPLICANT ADDRESS 109 VIE POINT LN MOORESVILLE NC 28117

LOCATION / DIRECTIONS LANGTREE, TR LAKE SHORE TR VIEW POINT, 1ST ON L

SUBDIVISION LAKEVIEW SHORES BLOCK / SECTION LOT # 17 LOT AREA .84AC DESIGN FLOW

Septic Tank 1000 Gallons: STB 312 Date 8-19-08

Pump Tank 1000 Gallons: P T 27 Date 7-21-08

Pump Make Zoeller Model N157 Serial #

Nitrification Field No Fields No Lines Linear Feet

Trench Width EXISTING Max. Trench Bottom Depth Gravel Depth

☐ New System ☐ Repair ☒ Expansion System Type I II III IV V VI

System Description: LP PANEL BLOCK

Repair System Description: LP PANEL BLOCK

Maintenance Agreement Required ☒ YES ☐ NO


☐ GRAVITY ☒ PRESSURE

☒ Residence ☐ Business ☐ Other ☒ Slab ☒ Basement


Comments / Conditions 1) INSTALL NEW SEPTIC + PUMP TANK 2) OLD TANKS MUST BE CRUSHED IN + FILLED

Comments / Conditions DRAINFIELD FINE AT TH... TANKS ...

INITIAL SITE SKETCH

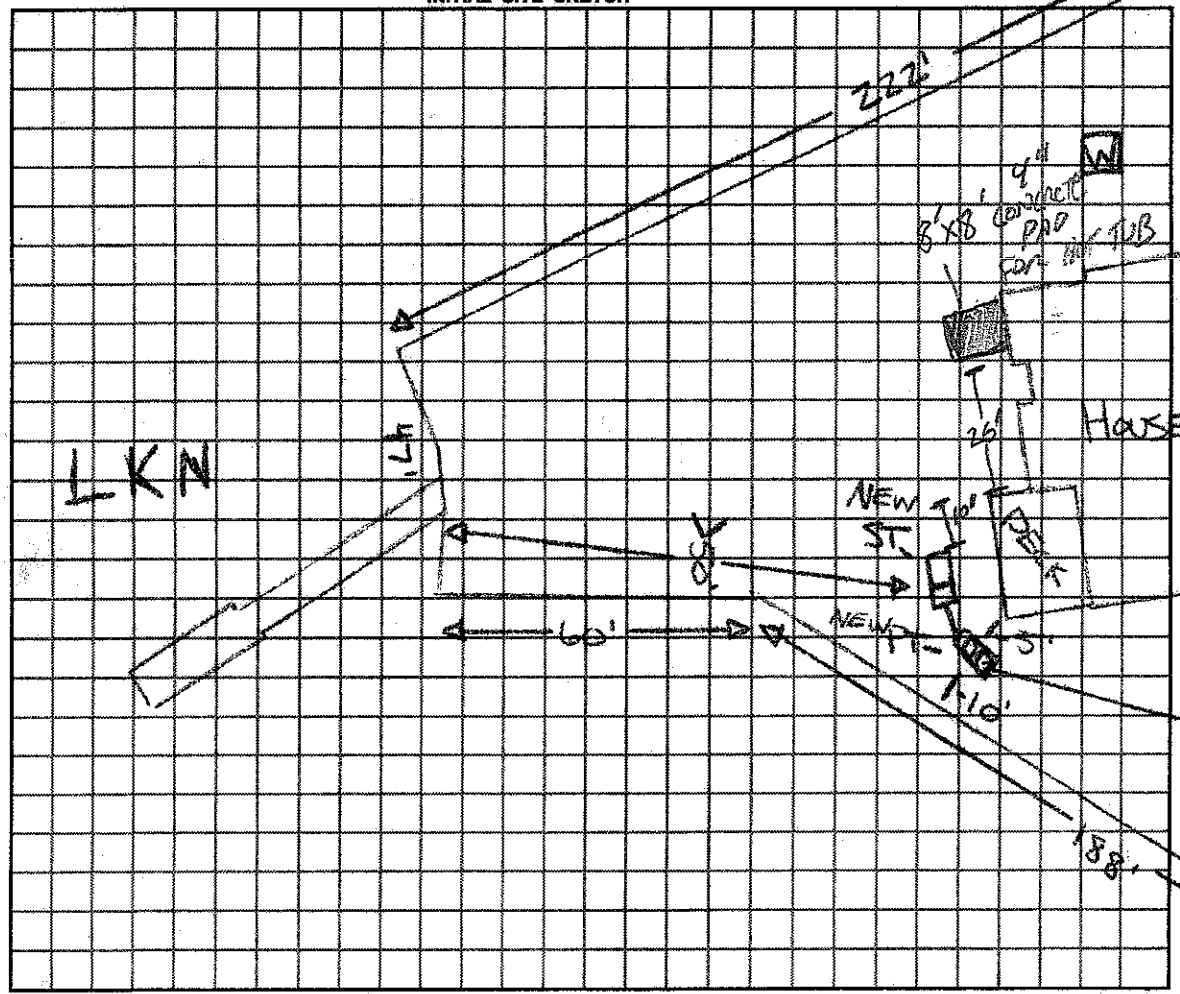

AS BUILT SKETCH

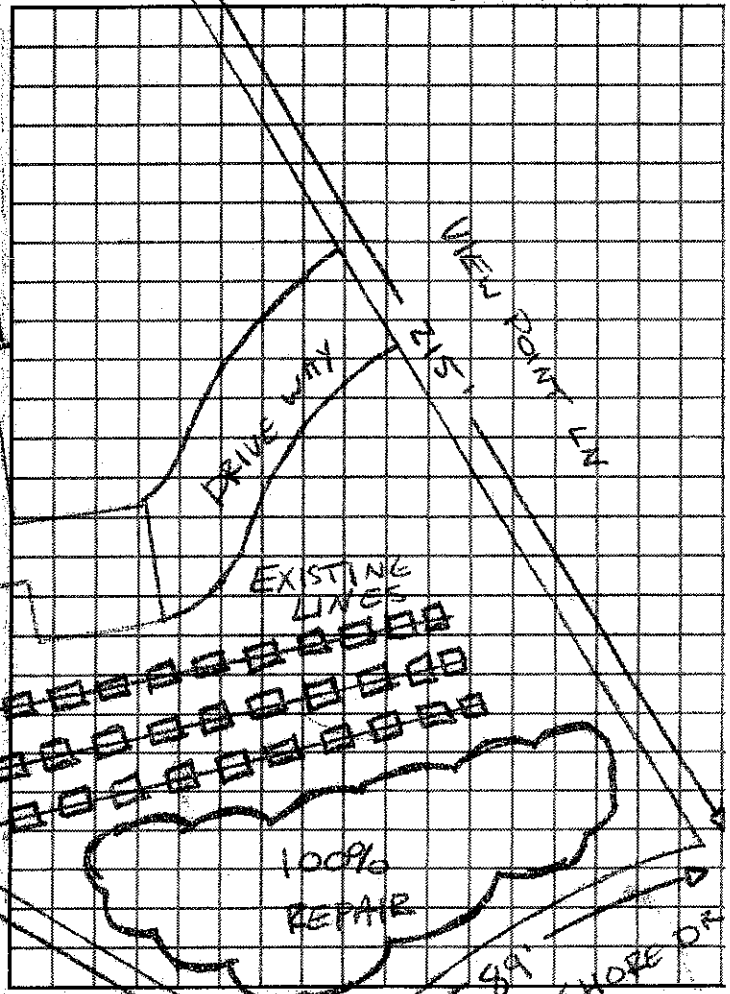

Permit can be suspended or revoked if any false information is supplied toward securing the permit / any unauthorized changes are made to the site / any unauthorized changes are made in the installation

☐ *IMPROVEMENT PERMIT w / plat valid without expiration.* ☒ *IMPROVEMENT PERMIT w / site plan valid for 60 mos.* ☒ *AUTHORIZATION TO CONSTRUCT valid for period equal to IM*