~~4635814070~~

IREDELL COUNTY HEALTH DEPARTMENT

STATESVILLE 704-878-5305 MOORESVILLE 704-664-5281

IMPROVEMENT PERMIT / CERTIFICATE OF COMPLETION / OPERATION PERMIT / EXISTING SYSTEM INSPECTION

PROPERTY DESCRIPTION NO. 25921 DATE 1/10/97 TAX MAP NO. 4635803988 Watershed: ☑ Yes ☐ No

OWNER OR CONTRACTOR JOHN LANGFORD PHONE: Business _____ Home 896-1957

ADDRESS 245 LAKESHORE DR MOORESVILLE NC 28115

LOCATION 115 S - TR LANTREE - TR LAKESHORE - # 245 LAKESHORE DR - ON LEFT

SUBDIVISION LAKEVIEW SHORES BLOCK / SECTION _____ LOT _____ LOT AREA _____ SITE CLASS. PS DESIGN FLOW 360 GPD L.T.A.R. .3 GPD/FT²

Septic Tank: EXISTING Gallons: STB _____ Date _____

Pump Tank: _____ Gallons: PC _____ Date _____

Pump Make: _____ Model _____ Serial No. _____

Nitrification Field: No Fields ____ Square Feet _____ Linear Feet _____

No Lines _____ Trench Width _____ Max Trench Bottom Depth _____ Gravel Depth _____

☐ New System ☐ Repair System Type: I, II, III, IV, V, VI

System Description: GRAVITY CONVENTIONAL

Repair System Description: _____

Maintenance Agreement Required: ☐ Yes ☐ No

☑ House/Mod. Home No. Bedrooms 3

☐ Mobile Home No. Bathrooms 2

☐ Business No. Employees ____

☐ Other _____


☐ Slab ☐ Crawl Space ☐ Basement w/plumbing ☐ Basement wo/plumbing

Water Supply:
☑ Individual
☐ Community
☐ Public

Comments:

Comments:

INITIAL SITE SKETCH

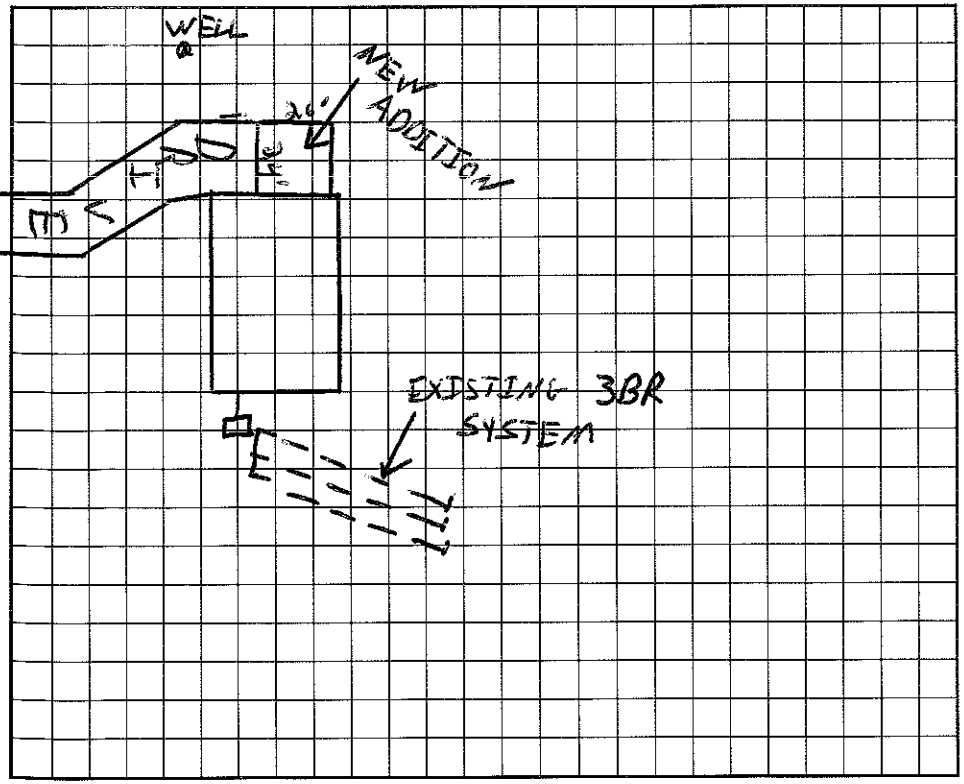

AS BUILT SKETCH

I understand that this permit can be suspended or revoked if any false information is supplied toward securing the permit/any unauthorized changes are made to the site/any unauthorized changes are made in the installation of the system. Improvement Permit is valid for 60 months from date of issuance.

Signed: John S Langford

Improvement Permit by: _____ date _____

Existing System Inspection by: C. Rob Tom date 1/10/97

Installed by: _____

Certificate of Completion by: _____ date _____

Operation Permit by: C. Rob Tom date 1/10/97

HEALTH DEPT. COPY: WHITE INSPECTION COPY (FINAL): GREEN OWNER COPY (FINAL): YELLOW INSPECTION COPY (INITIAL): PINK OWNER COPY (INITIAL): GOLD