IREDELL COUNTY HEALTH DEPARTMENT

STATESVILLE 704-878-5305 $375 MOORESVILLE 704-664-5281

IMPROVEMENT PERMIT / AUTHORIZATION TO CONSTRUCT / OPERATION PERMIT / EXISTING SYSTEM INSPECTION

PERMIT# 119400 PIN# 4635-81-8578 DATE 3/30/04

OWNER OR CONTRACTOR Spectrum Building Co., Inc. PHONE: Business 704-528-2022 Home

ADDRESS 136-C Oswalt-Amity Rd Troutman NC 2166

LOCATION Langtree, TR Lakeshore Dr, on Rt # 202

SUBDIVISION Lakeview Shores BLOCK / SECTION D LOT 5 LOT AREA SITE CLASS. PS DESIGN FLOW 480 L.T.A.R. 0.2

Septic Tank: 1000 Gallons; STB 338 Date 12/6/04
Pump Tank: 1000 Gallons; PT 29 Date 11/8/04
Pump Make: MYERS Model ME-50S-21 Serial No.
Nitrification Field: No Fields 1 Square Feet 1200 Linear Feet 400
No Lines 7@56' Trench Width 24" Max Trench Bottom Depth 36" Gravel Depth —

☒ New System ☐ Repair System Type: I, II, III, IV, V, VI
System Description: LP Panel Block
Repair System Description: <100% Dead Prior to
Maintenance Agreement Required: ☒ Yes ☐ No 1983

☒ House/Mod. Home ☐ Mobile Home ☐ Business ☐ Other
No. Bedrooms 4 No. Bathrooms 3½ No. Employees


☐ Slab ☒ Crawl Space ☐ Basement w/plumbing ☐ Basement wo/plumbing

Water Supply: ☐ Individual ☐ Public ☐ Community


Comments/Conditions: * old well must be Abandoned - Need Abandonment form prior to O.P.

Comments/Conditions:

INITIAL SITE SKETCH 1"=40'

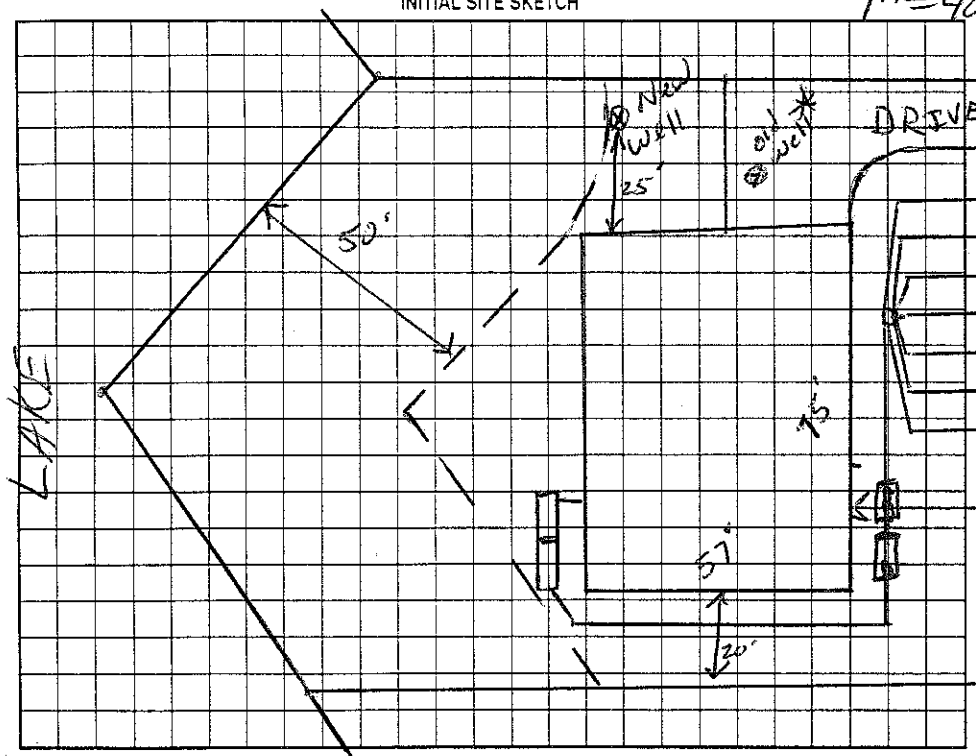

AS BUILT SKETCH

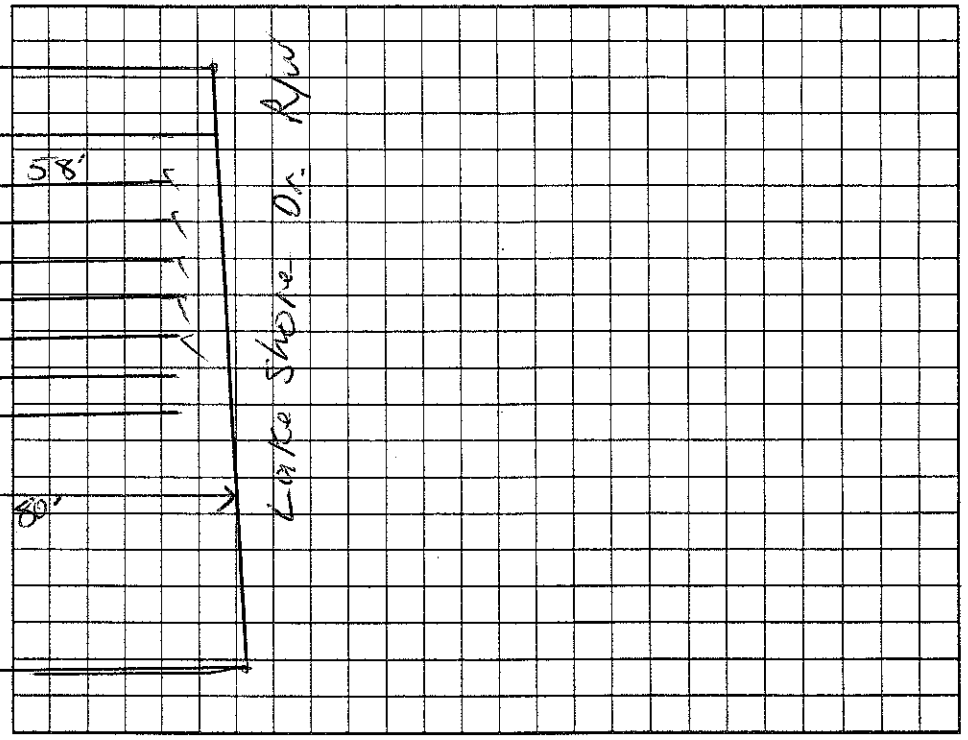

Permit can be suspended or revoked if any false information is supplied toward securing the permit/any unauthorized changes are made to the site/any unauthorized changes are made in the installation of the system. Improvement Permit with plat valid without expiration. Improvement Permit with site plan valid for sixty months. Authorization to Construct is valid for a period equal to that of Improvement Permit – not to exceed sixty months.

Signed: R.Williams date

Improvement Permit by: RS date 3/30/04

Authorization to Construct by: RS date 3/30/04

Installed by: Stanley Septic Service

Operation Permit by: Wesley Parker RS. date 4/26/05

Existing System Inspection by: date

HEALTH DEPT. COPY: WHITE OWNER COPY (FINAL): YELLOW OWNER COPY (INITIAL): PINK