# IREDELL COUNTY HEALTH DEPARTMENT

Authorization to Construct

STATESVILLE 704-878-5305 MOORESVILLE 704-664-5281

## IMPROVEMENT PERMIT / ~~CERTIFICATE OF COMPLETION~~ / OPERATION PERMIT / EXISTING SYSTEM INSPECTION

PROPERTY DESCRIPTION NO. 24262 (94495) DATE 8/6/97 TAX MAP NO. 2B 1A 29 463581 8649 Watershed: ☒ Yes ☐ No

OWNER OR CONTRACTOR R F Eller / Larry Core PHONE: Business _____ Home 464-3688

ADDRESS PO Box 580 Davidson, NC. 28036

LOCATION Langtree Rd. TR Lakeshore Dr. around shoreline to lots on (R)

SUBDIVISION Lakeview Shores BLOCK / SECTION _____ LOT 6 LOT AREA 1.6AC SITE CLASS. PS DESIGN FLOW 480 L.T.A.R. _____

Septic Tank: 1000 Gallons; STB 317 Date 4/19/99

Pump Tank: 1000 Gallons; PT 283 Date 6/3/01

Pump Make: MYERS Model ME3F-11 Serial No. 2L2290000

Nitrification Field: No Fields 1 Square Feet 1080 Linear Feet 360

No Lines 4 Trench Width 36" Max Trench Bottom Depth 36" Gravel Depth STNO

☒ New System ☐ Repair System Type: I, II, (III), IV, V, VI

System Description: Pre Manifold - Ch Plastic

Repair System Description: Same

Maintenance Agreement Required: ☐ Yes ☒ No

☒ House/Mod. Home No. Bedrooms 4

☐ Mobile Home No. Bathrooms 3

☐ Business No. Employees ____

☐ Other _____


☐ Slab ☒ Crawl Space ☐ Basement w/plumbing ☐ Basement wo/plumbing

Water Supply: ☒ Individual ☐ Community ☐ Public


Comments: 25% reduction for Ch. Plastic use

Comments: 83 panels -

**INITIAL SITE SKETCH**

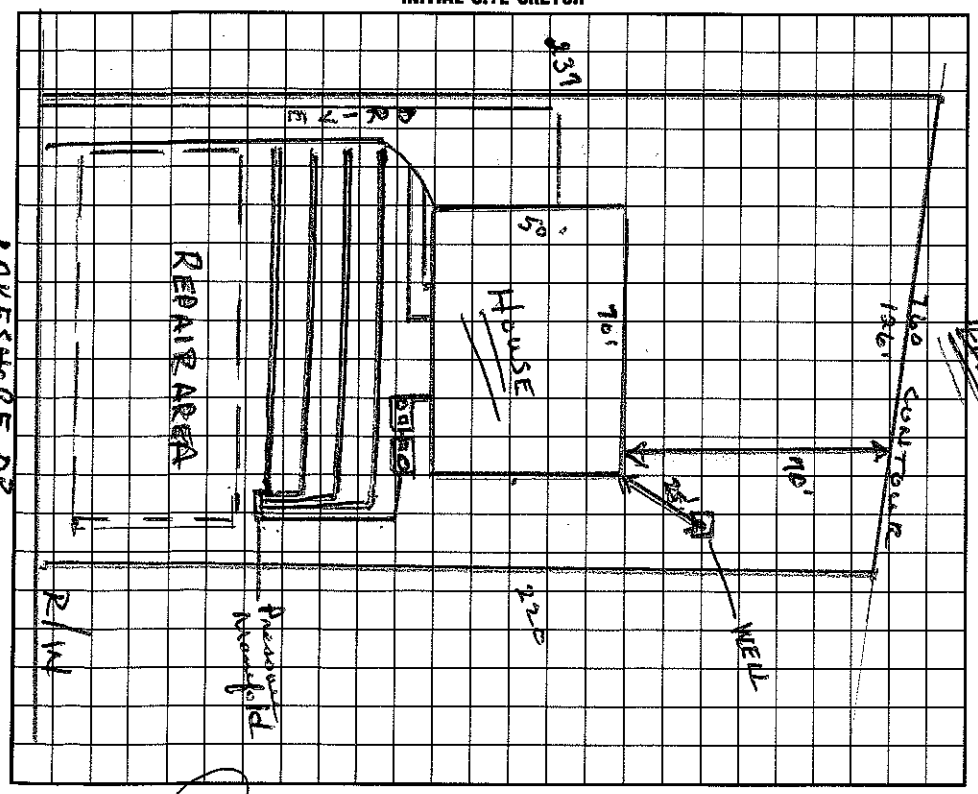


**AS BUILT SKETCH**

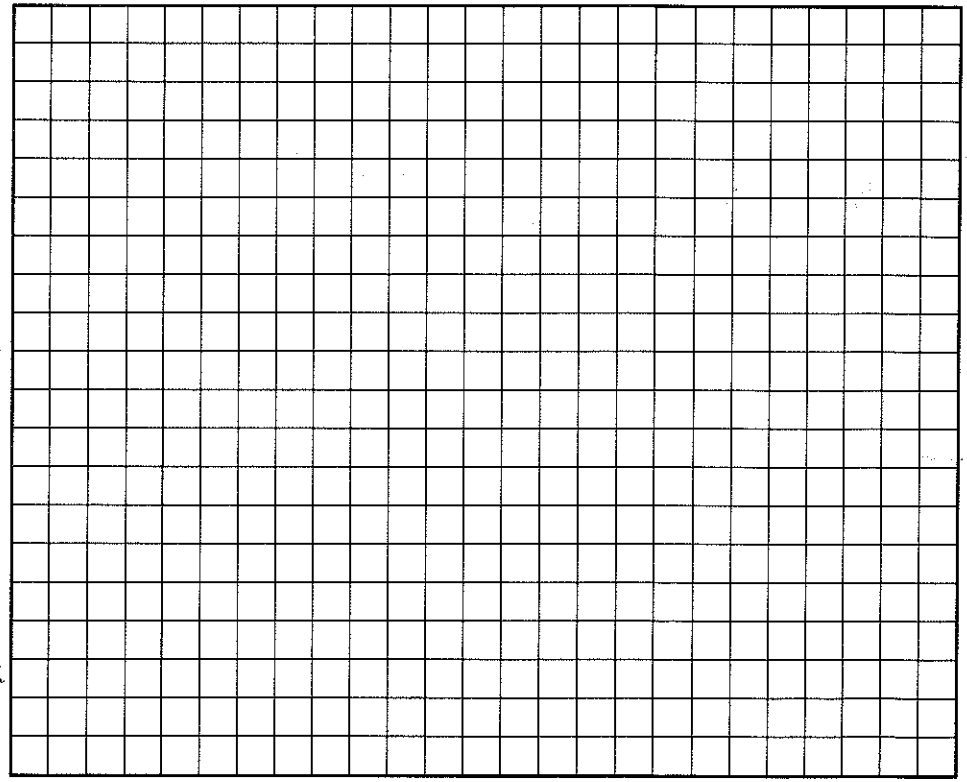


I understand that this permit can be suspended or revoked if any false information is supplied toward securing the permit/any unauthorized changes are made to the site/any unauthorized changes are made in the installation of the system. Improvement Permit is valid for 60 months from date of issuance.

Signed: _____

Improvement Permit by: Wesley Sparks RS. date 8/6/97

~~Existing System Inspection~~ by: Wesley Sparks RS. date 8/6/97

Installed by: Bob McCraw

Certificate of Completion by: Wesley Sparks RS. date 11/6/01

Operation Permit by: Wesley Sparks RS. date 11/6/01

HEALTH DEPT. COPY: WHITE | INSPECTION COPY (FINAL): GREEN | OWNER COPY (FINAL): YELLOW | INSPECTION COPY (INITIAL): PINK | OWNER COPY (INITIAL): GOLD