# IREDELL COUNTY HEALTH DEPARTMENT

Authorization to Construct

STATESVILLE 704-878-5305 MOORESVILLE 704-664-5281

## IMPROVEMENT PERMIT / ~~CERTIFICATE OF COMPLETION~~ / OPERATION PERMIT / EXISTING SYSTEM INSPECTION

PROPERTY DESCRIPTION NO. 24263 DATE 8/6/97 TAX MAP NO. 2B 1A 49 4635818831 Watershed: X Yes ☐ No

OWNER OR CONTRACTOR RF Eller PHONE: Business _____ Home 664-3688

ADDRESS PO Box 580 Davidson, NC. 28036

LOCATION Longview Rd TR Lakeshore Dr. around sharp curve on (R) side

SUBDIVISION LAKEVIEW SHORES BLOCK / SECTION D LOT 7 LOT AREA .51 Ac SITE CLASS. PS DESIGN FLOW 360 L.T.A.R. .3

Septic Tank: 1000 Gallons; STB 794 Date 12/13/97

Pump Tank: 1000 Gallons; PT 27 Date 12/2/97

Pump Make: HYDROMATIC Model SK50A1 Serial No. 12/97

Nitrification Field: No Fields 1 Square Feet 900 Linear Feet 300

No Lines 4 Trench Width 36" Max Trench Bottom Depth 36" Gravel Depth SAND.

X New System ☐ Repair System Type: I, II, (III) IV, V, VI

System Description: Pass Manifold - CH. PLASTIC

Repair System Description: SAME

Maintenance Agreement Required: ☐ Yes X No

X House/Mod. Home No. Bedrooms 3

☐ Mobile Home No. Bathrooms 2.5

☐ Business No. Employees ____

☐ Other ____


☐ Slab X Crawl Space ☐ Basement w/plumbing ☐ Basement wo/plumbing

Water Supply: X Individual ☐ Community ☐ Public

Comments: 25% reduction for use of CH. Plastic

Comments:

### INITIAL SITE SKETCH

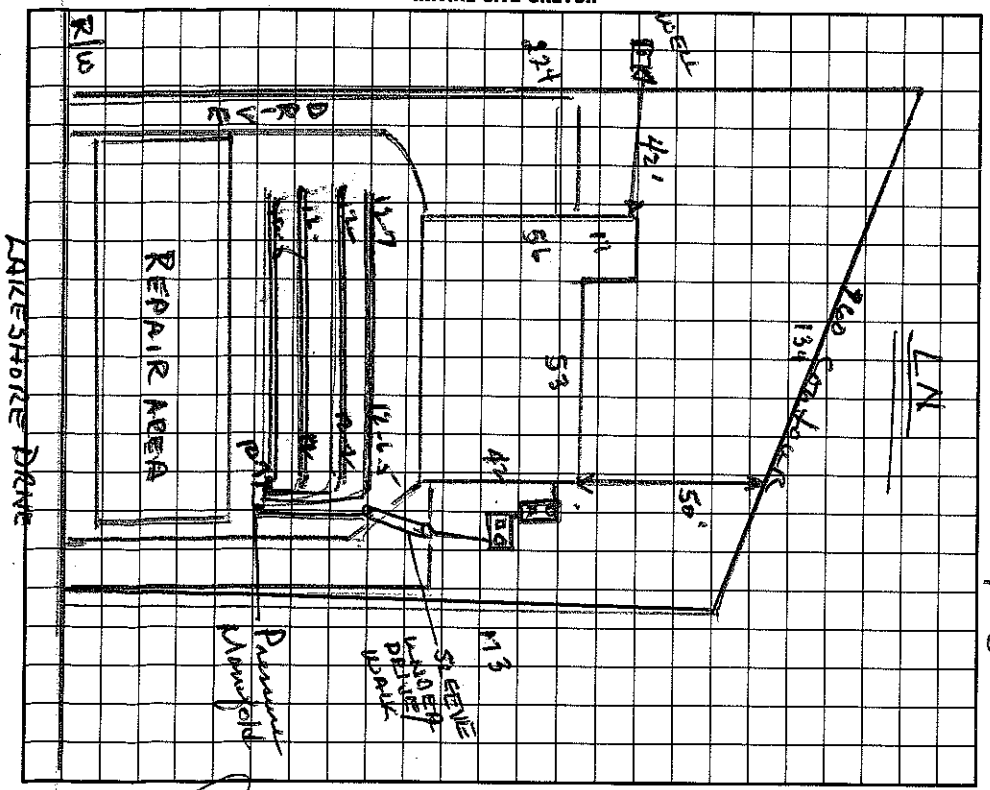


### AS BUILT SKETCH

I understand that this permit can be suspended or revoked if any false information is supplied toward securing the permit/any unauthorized changes are made to the site/any unauthorized changes are made in the installation of the system. Improvement Permit is valid for 60 months from date of issuance.

Signed: X R F Eller

Improvement Permit by: Wesley Sparks RS. date 8/6/97

~~Existing System Inspection by:~~ Wesley Sparks RS. date 8/6/97

Installed by: Bob Mayhew

Certificate of Completion by: Wesley Sparks RS. date 3/5/98

Operation Permit by: Wesley Sparks RS. date 3/5/98

HEALTH DEPT. COPY: WHITE INSPECTION COPY (FINAL): GREEN OWNER COPY (FINAL): YELLOW INSPECTION COPY (INITIAL): PINK OWNER COPY (INITIAL): GOLD