IREDELL COUNTY HEALTH DEPARTMENT

STATESVILLE 704-878-5305 700.00 Paid MOORESVILLE 704-664-5281

IMPROVEMENT PERMIT / AUTHORIZATION TO CONSTRUCT / OPERATION PERMIT / EXISTING SYSTEM INSPECTION

PERMIT# 131422 PIN# 4635 85 7838.000 4635-85-7779 DATE 10/18/05

OWNER OR APPLICANT Steven H Bradley PHONE: Business 704-662-0877 Home

ADDRESS 228 Sherwood Pines Dr. Mooresville, NC. 28115

LOCATION Williamson ST R Rlene Tr Templeton TL Covino Real on (L)

SUBDIVISION Lakeview Park BLOCK / SECTION LOT 19+20 LOT AREA 2.3Ac SITE CLASS. PS DESIGN FLOW 600 L.T.A.R. .25

Septic Tank: 1500/1000 Gallons; STB 268 Date 9/22/04
Pump Tank: 1500 Gallons; PT 247 Date 10/7/04
Pump Make: ZOELLER Model N-153 B Serial No. 1109
Nitrification Field: No Fields 1 Square Feet 1200 Linear Feet 400
No Lines 8 Trench Width 3' Max Trench Bottom Depth 30-32" Gravel Depth No ☐ Gravity ☒ Pressure ☐ Slab ☒ Crawl Space ☐ Basement w/plumbing ☐ Basement wo/plumbing

☒ New System ☐ Repair ☐ Expansion System Type: I II III (IV) V VI
System Description: LPP - PRBRS 16"
Repair System Description: JAMC
Maintenance Agreement Required: ☐ Yes ☐ No


☒ House/Mod. Home No. Bedrooms 5
☐ Mobile Home No. Persons 5
☐ Business No. Employees
☐ Other

Water Supply: ☒ Individual ☐ Public ☐ Community NEW


Comments:/Conditions:

Comments:/Conditions:

INITIAL SITE SKETCH

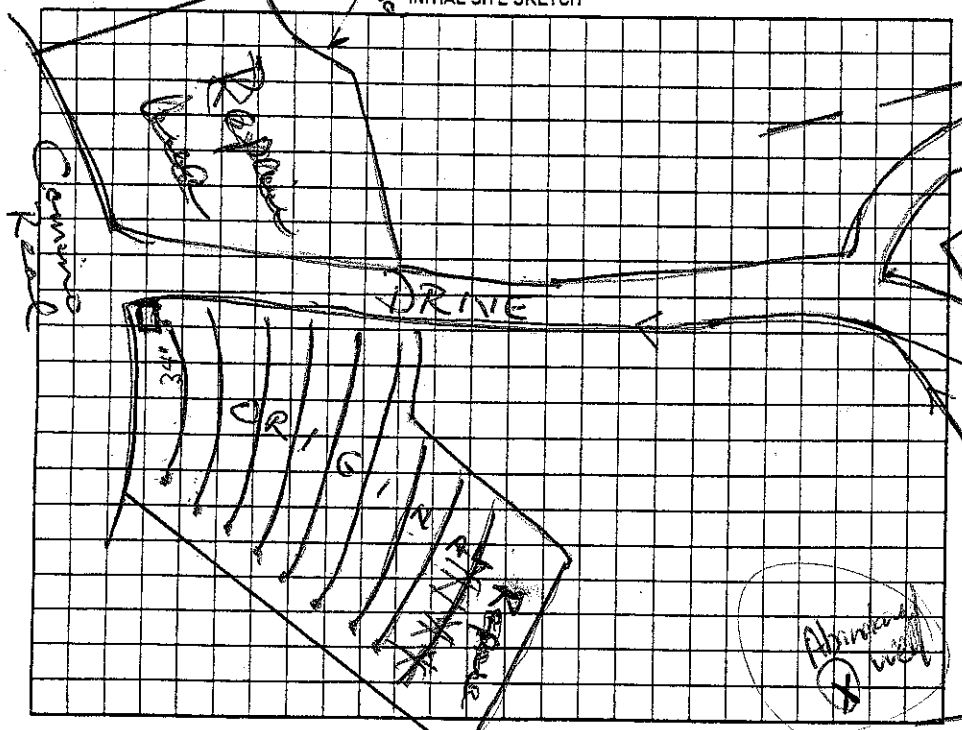

AS BUILT SKETCH

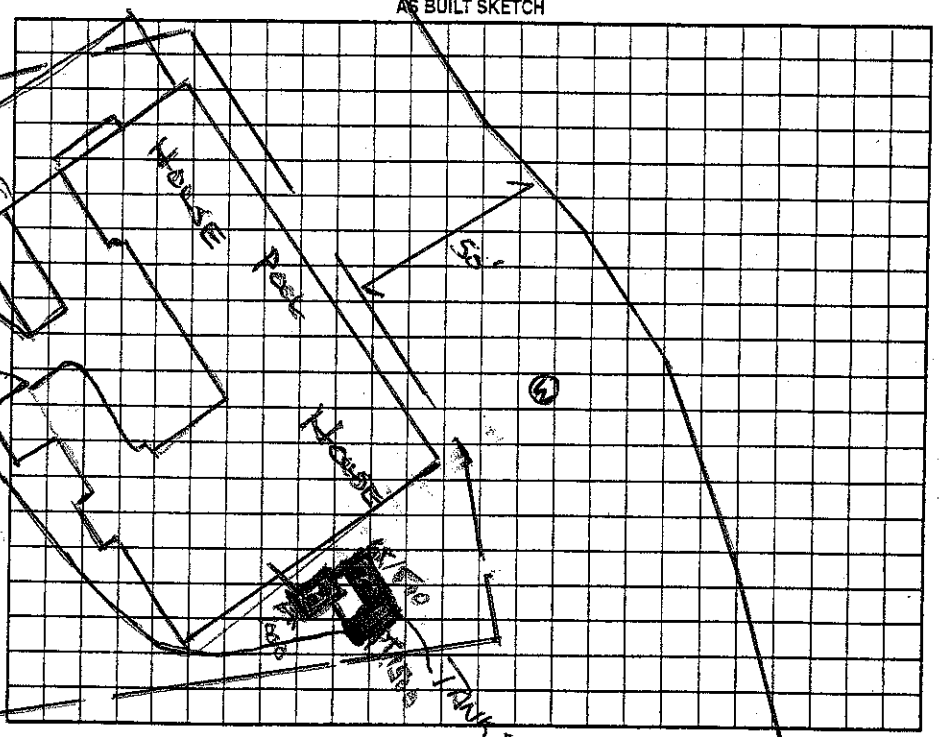

Permit can be suspended or revoked if any false information is supplied toward securing the permit/any unauthorized changes are made to the site/any unauthorized changes are made in the installation of the system. Improvement Permit with plat valid without expiration ☐ Improvement Permit with site plan valid for sixty months ☐ Authorization to Construct is valid for a period equal to that of Improvement Permit – not to exceed sixty months.

Signed: x Robert Dellinger date 10/21/05 Installed by: Wayne Moontz

Improvement Permit by: Wesley Sparks R.S. date 10/17/05 Operation Permit by: Gary Mabeth date 6-17-09

Authorization to Construct by: Wesley Sparks R.S. date 10/17/05 Existing System Inspection by: date

HEALTH DEPT. COPY: WHITE OWNER COPY (FINAL): YELLOW OWNER COPY (INITIAL): PINK