IREDELL COUNTY HEALTH DEPARTMENT

STATESVILLE 704-8[illegible]305 Paid 125.00 [illegible]64.5281 MOORESVILLE

IMPROVEMENT PERMIT / AUTHORIZATION TO CONSTRUCT / OPERATION PERMIT / EXISTING SYSTEM INSPECTION

PERMIT# 88466 PIN# 4635863230 DATE 3/29/00

OWNER OR CONTRACTOR TIMOTHY MULLEN PHONE: Business 948-9240 Home

ADDRESS 7615 HINMAN CR. HUNTERSVILLE NC 28078

LOCATION WILLIAMSON- TR ALCOVE - TR TEMPLETON- FORK TO LEFT ON CAMINO REAL - 3RD FROM END ON RT

SUBDIVISION LAKEVIEW PARK BLOCK / SECTION LOT 9 LOT AREA .77AC SITE CLASS PS DESIGN FLOW 360gpd L.T.A.R. .3 gpd/ft²

Septic Tank: ~~1000~~ Gallons; STB 338 Date ~~8-26-2000~~ ☑ New System ☐ Repair System Type: I, II, III, IV, V, VI

Pump Tank: 1500 Gallons; PT Date

Pump Make: Model Serial No.

Nitrification Field: No Fields 1 Square Feet 600 Linear Feet 200

No Lines 4 Trench Width 36" Max Trench Bottom Depth 36" Gravel Depth N/A

System Description: GRAVITY PANEL

Repair System Description: LP PANEL

Maintenance Agreement Required: ☐ Yes ☑ No

☑ House/Mod. Home No. Bedrooms 3

☐ Mobile Home No. Bathrooms 2

☐ Business No. Employees

☐ Other

☐ Slab ☑ Crawl Space ☐ Basement w/plumbing ☐ Basement wo/plumbing

Water Supply: ☑ Individual ☐ Public ☐ Community


Comments:/Conditions: 1) SUGGESTED REMOVING MAPLE TREE. 2) KEEP SYSTEM 5' FROM HOUSE AND 50' FROM LAKE. 3) OLD SEPTIC SYSTEM LOCATED UNDER NEW HOUSE, TO BE ABANDONED AND DESPOSED OF PROPERLY.

Comments:/Conditions: Filter & riser installed


Checked 2 lower lines 10/13/2000.

Checked upper 2 lines & D-Box OK

INITIAL SITE SKETCH (1"=50')

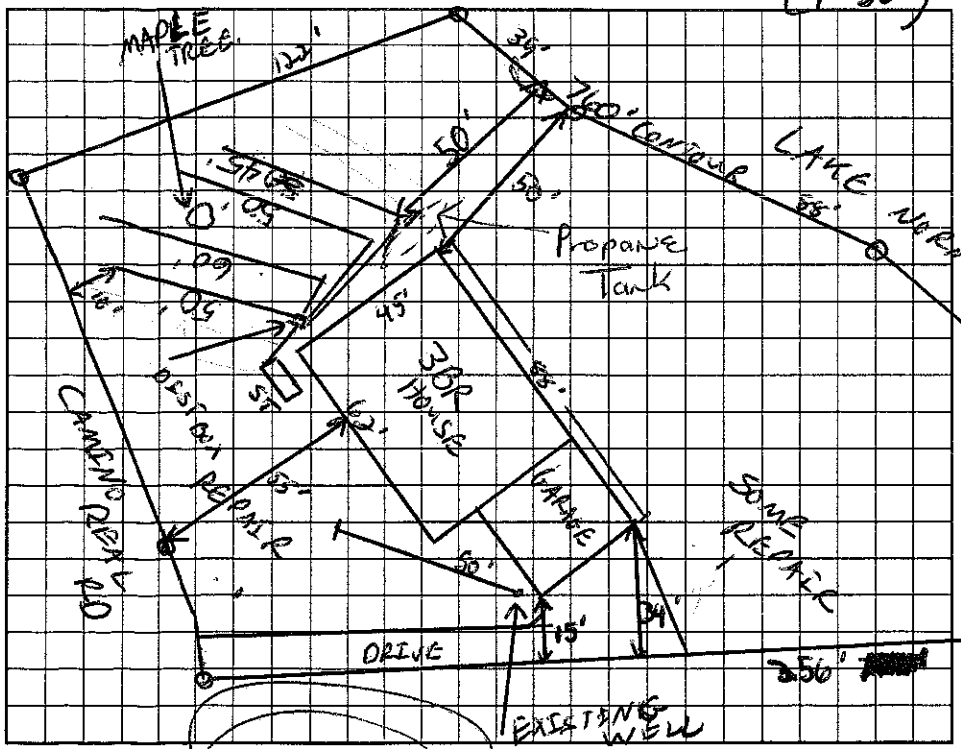

AS BUILT SKETCH

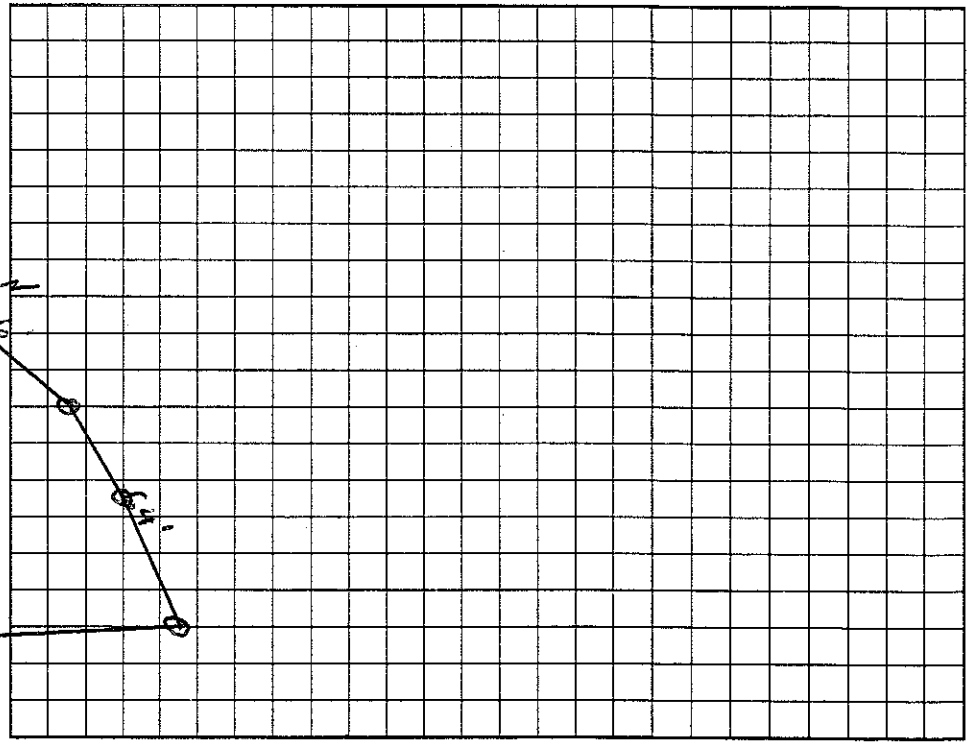

Permit can be suspended or revoked if any false information is supplied toward securing the permit/any unauthorized changes are made to the site/any unauthorized changes are made in the installation of the system. Improvement Permit with plat valid without expiration. Improvement Permit with site plan valid for sixty months. Authorization to Construct is valid for a period equal to that of Improvement Permit – not to exceed sixty months.

Signed: date 3/31/00 Installed by: Allred Grading

Improvement Permit by: [signature] RS date 3/29/00 Operation Permit by: [signature], RS date 10-18-00

Authorization to Construct by: [signature] RS date 3/29/00 Existing System Inspection by: date

HEALTH DEPT. COPY: WHITE OWNER COPY (FINAL): YELLOW OWNER COPY (INITIAL): PINK