Permit #209966

IREDELL COUNTY HEALTH DEPARTMENT

Statesville Office – Central Permitting (704) 878-5305 Mooresville Office ~~(704) 660-3625~~


PRIVATE DRINKING WATER WELL PERMIT # 209966 **PIN #** 4635863230 **Type of Permit (circle one): New Repair Abandonment**

APPLICANT NAME: Richard Scherezinger ADDRESS: 350 Camino Real Rd Mooresville PHONE: ~~704-881-1689~~


DIRECTIONS TO SITE: Hwy 21 S TL Alcove Rd TR Templeton TL A Fork Camino Real on right

SITE ADDRESS: 350 Camino Real SUBDIVISION: Lakeview Park SECTION/LOT: 9

Initial Site Sketch

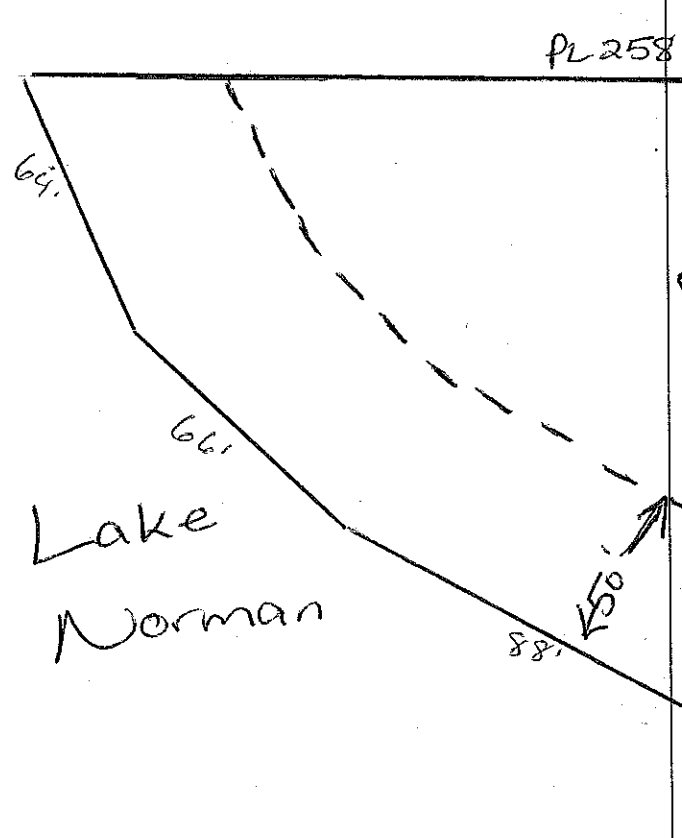

"As Built" Sketch

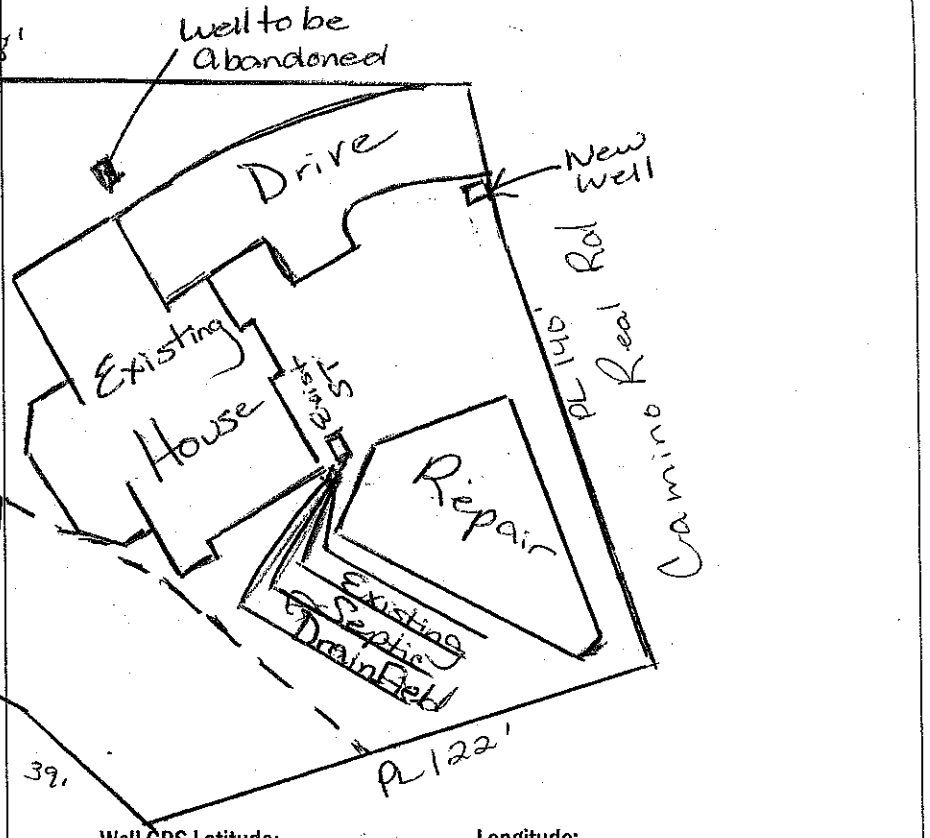

Well GPS Latitude: _____ Longitude: _____

PERMIT CONDITIONS/COMMENTS: Follow NC Well Construction rules for abandonment

WELL PERMIT ISSUED BY: Marie Dotson DATE: 5/15/15 (Permit is valid for 5 years from date issued. This permit may be revoked if it is determined there has been a material change in any fact or circumstance upon which the permit is issued. Actions of the employees of the Iredell County Health Department shall in no way be taken as a guarantee that this well will produce water of any particular quantity or quality or for any amount of time. Employees of the Iredell County Health Department assume no liability for any damages, either direct or consequential which may be caused by this well.)

Well Contractor: Ace Drilling CONTRACTOR CERT #: _____ GROUT INSPECTION BY: _____ DATE: _____

OR CERTIFICATION OF GROUT NOT WITNESSED BY DEPT: _____ DATE: 6/22/15 WELL HEAD INSPECTION BY: _____ DATE: _____

WELL HEAD INSPECTION (check when completed): GROUT TO GROUND SURFACE ☐ WELL CONTRACTOR ID PLATE ☐ PUMP INSTALLER ID PLATE ☐ SAMPLE PORT ☐

ACCESS PORT / VENT ☐ WELL SEAL ☐ WELL HEAD 12 INCHES / PITLESS ADAPTOR 8 INCHES ABOVE GRADE ☐

CERTIFICATE OF COMPLETION BY: _____ APPROVED JUN 22 2015 WATER SAMPLES BY: _____ DATE: _____

~~Attachments~~: Form GW-1a (required except for abandonment) ☐ Form GW-30 ☒ Water Sample Results ☐ Plat ☐

Health Dept. Copy – White Applicant Certificate of Completion – Yellow Applicant Well Construction Permit - Pink