IREDELL COUNTY HEALTH DEPARTMENT

Statesville Office (704) 878-5305 Mooresville Office (704) 660-3625 PERMIT # 176922

IMPROVEMENT PERMIT / AUTHORIZATION TO CONSTRUCT / OPERATION PERMIT / EXISTING SYSTEM

PIN # 4635-86-6277

APPLICANT: TINA OUELLETTE APPLICANT ADDRESS: 338 CAMINO REAL

SITE ADDRESS: SAME PHONE: 980-253-7575 ALT. PHONE: 980-253-7576


SITE DIRECTIONS: ALCOVE, TEMPLETON, CAMINO REAL, ON R

SUBDIVISION: LAKEVIEW PARK SECTION: LOT # 6 LOT AREA: DESIGN FLOW: L.T.A.R.: .25


Septic Tank	EXISTING (gal)	STB	Date	☐ New System	☒ Repair	☐ Expansion	System Type: I II (III) IV V VI	☒ Residence	No. Bedrooms	3	Water Supply
Pump Tank	(gal)	PT	Date	System Description:				☐ Business	No. Persons		☒ Private
Pump Make	Model		Serial #	Repair System Description:	25% RED.			☐ Other	No. Employees		☐ Public
# Nitrification Fields	1 # Lines	6	Linear Ft: 289'*	Maintenance Agreement Required:	☐ YES	☒ NO		☐ Slab	☒ Crawl Space		☐ Community
Trench Width	36" Max. Trench Bottom Depth	24"	Gravel Depth		☒ GRAVITY	☐ PRESSURE		☐ Basement w/plumbing		☐ Basement w/o plumbing	

Comments / Conditions: ① INSTALL 289' OR MAX POSSIBLE ② INSTALL BULL RUN VALVE TO SWITCH BETWEEN 2 SYSTEMS ③ TANK MUST HAVE FILTER ④ EX. TANK DOES NOT MEET PROPERTY LINE SETBACK

INITIAL SITE SKETCH

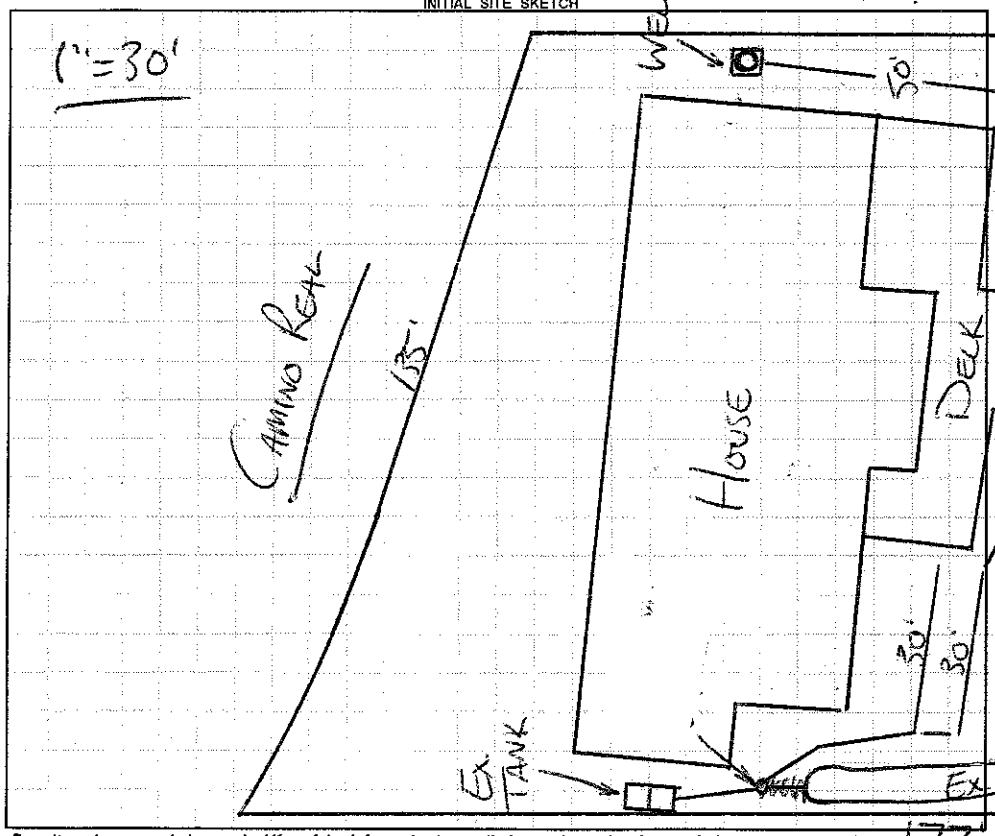

AS BUILT SKETCH

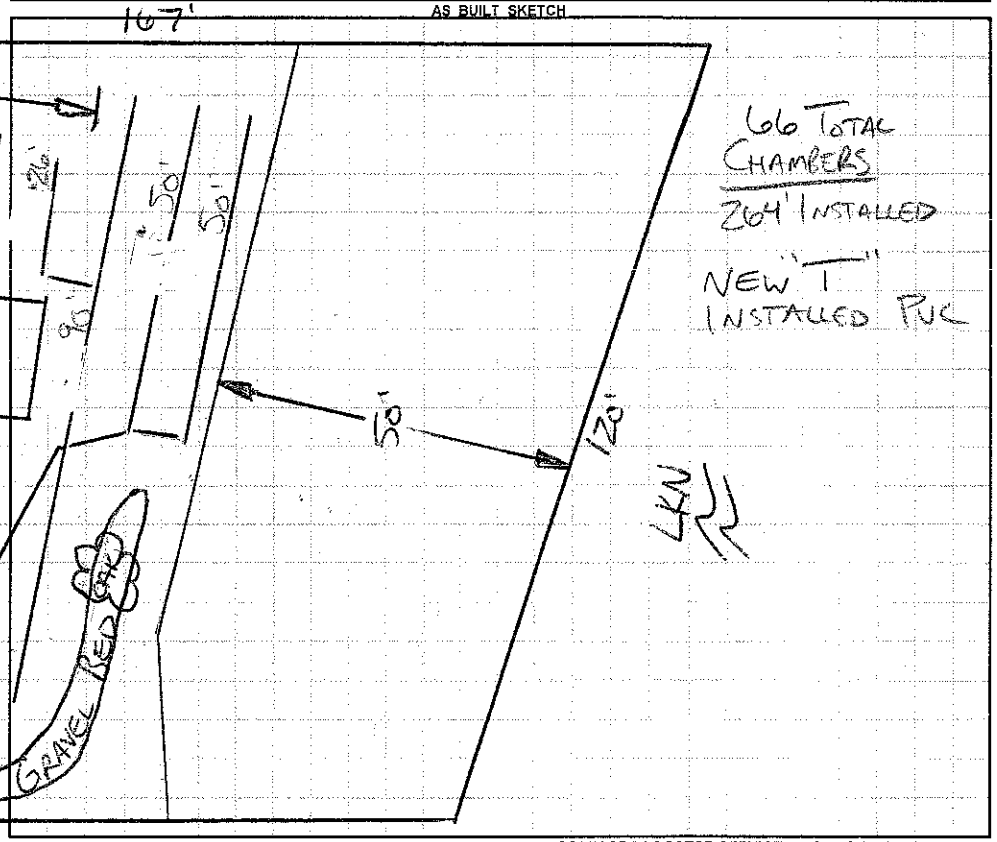

Permit can be suspended or revoked if any false information is supplied toward securing the permit / any unauthorized changes are made to the site / any unauthorized changes are made in the installation of the system. **CONTACT A LOCATOR SERVICE PRIOR TO ANY EXCAVATION**

☐ **IMPROVEMENT PERMIT** *with plat valid without expiration.* ☐ **IMPROVEMENT PERMIT** *with site plan valid for 60 mos.* ☒ **AUTHORIZATION TO CONSTRUCT** *valid for period equal to IMPROVEMENT PERMIT--not to exceed 60 mo.*

Owner / Applicant Signature: Date: 3-5-13 Installed by: ROWAN SEPTIC

IMPROVEMENT PERMIT by: Date: 3-11-13 OPERATION PERMIT by: Date: 3-22-13

AUTHORIZATION TO CONSTRUCT by: Date: 3-11-13 Existing System Inspected by: Date:

Health Dept. Copy - WHITE Applicant (Final Approval) - YELLOW Applicant (Conditional Approval) - PINK