IREDELL COUNTY HEALTH DEPARTMENT

Statesville Office (704) 878-5305 Mooresville Office (704) 660-3625

Old # 17392723-5

PERMIT # 214694

IMPROVEMENT PERMIT / AUTHORIZATION TO CONSTRUCT / OPERATION PERMIT / EXISTING SYSTEM

PIN # 4635-90-0572

APPLICANT: MARK SIMONIAN

APPLICANT ADDRESS: 115 LAKESHORE DR.

SITE ADDRESS: 704 LANGTREE RD- Mooresville

PHONE: 704-701-2653 ALT. PHONE:

SITE DIRECTIONS: I-77, TR LANGTREE, ON R

SUBDIVISION: LAKEVIEW SHORES


SECTION: 2 LOT # 14 LOT AREA: .448 AC DESIGN FLOW: 360 L.T.A.R.: .3

Septic Tank	1000 (gal)	STB	1160	Date	7/14/16	☒ New System ☐ Repair ☐ Expansion	System Type: I II (III) IV V VI	☒ Residence	No. Bedrooms 3
Pump Tank	(gal)	PT		Date		System Description:	25% REDUCTION	☐ Business	No. Persons
Pump Make	Model			Serial #		Repair System Description:	< 1983	☐ Other	No. Employees
# Nitrification Fields	1	# Lines	5	Linear Ft:	300'	Maintenance Agreement Required:	☐ YES ☒ NO	☒ Slab	☒ Crawl Space
Trench Width	36"	Max. Trench Bottom Depth	36"	Gravel Depth	—	☒ GRAVITY	☐ PRESSURE	☐ Basement w/plumbing	☐ Basement w/o plumbing

Water Supply: ☒ Private ☐ Public ☐ Community

Comments / Conditions:

INITIAL SITE SKETCH

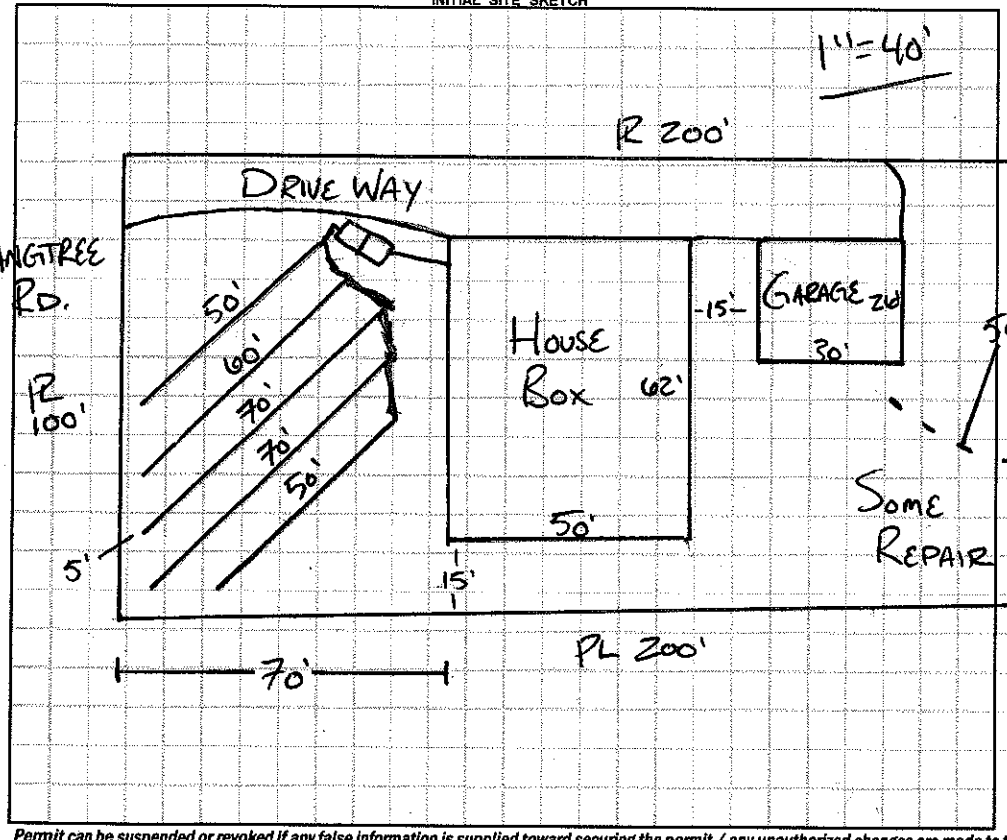

AS BUILT SKETCH

Permit can be suspended or revoked if any false information is supplied toward securing the permit / any unauthorized changes are made to the site / any unauthorized changes are made in the installation of the system. **CONTACT A LOCATOR SERVICE PRIOR TO ANY EXCAVATION**

☐ **IMPROVEMENT PERMIT** *with plat valid without expiration.* ☒ **IMPROVEMENT PERMIT** *with site plan valid for 60 mos.* ☒ **AUTHORIZATION TO CONSTRUCT** *valid for period equal to IMPROVEMENT PERMIT--not to exceed 60 mo.*

Owner / Applicant Signature: Mark Simonian Date: 12/7/2015 Installed by: Piedmont Septic Tank

IMPROVEMENT PERMIT by: APPROVED Date: DEC 03 2015 OPERATION PERMIT by: Date: 10/6/16

AUTHORIZATION TO CONSTRUCT by: Date: 3-11-2016 Existing System Inspected by: Date:

Health Dept. Copy - WHITE Applicant (Final Approval) - YELLOW Applicant (Conditional Approval) - PINK