IREDELL COUNTY HEALTH DEPARTMENT

Statesville Office (704) 878-5305 Mooresville Office (704) 660-3625 PERMIT # 206808

IMPROVEMENT PERMIT / AUTHORIZATION TO CONSTRUCT / OPERATION PERMIT / EXISTING SYSTEM

PIN # 4635-90-0784

APPLICANT: KEITH BARTGIS APPLICANT ADDRESS: 9764 WHITEWOOD TR. CLT

SITE ADDRESS: 117 AQUA DR. PHONE: 704-819-0299 ALT. PHONE:

SITE DIRECTIONS: LANGTREE, TR LAKESHORE, TL AQUA, ON L

SUBDIVISION: LAKE VIEW SHORES SECTION: 2 LOT # 20 LOT AREA: .46AC DESIGN FLOW: 360 L.T.A.R.: .2

Septic Tank 1000 (gal) STB Date
Pump Tank (gal) PT Date
Pump Make Model Serial #
Nitrification Fields 1 # Lines 5 Linear Ft: 450'
Trench Width 36" Max. Trench Bottom Depth 36" Gravel Depth —

☒ New System ☐ Repair ☐ Expansion System Type: I II (III) IV V VI
System Description: 25% REDUCTION
Repair System Description: NOT REQUIRED
Maintenance Agreement Required: ☐ YES ☒ NO
☒ GRAVITY ☐ PRESSURE


☒ Residence ☐ Business ☐ Other ☐ Slab ☒ Crawl Space ☐ Basement w/plumbing ☐ Basement w/o plumbing
No. Bedrooms 3 No. Persons No. Employees

Water Supply: ☒ Private ☐ Public ☐ Community

Comments / Conditions:

Used Quick 4, Serial distribution
Installed essentially as drawn.
* Divert stormwater away from Drainfield

INITIAL SITE SKETCH

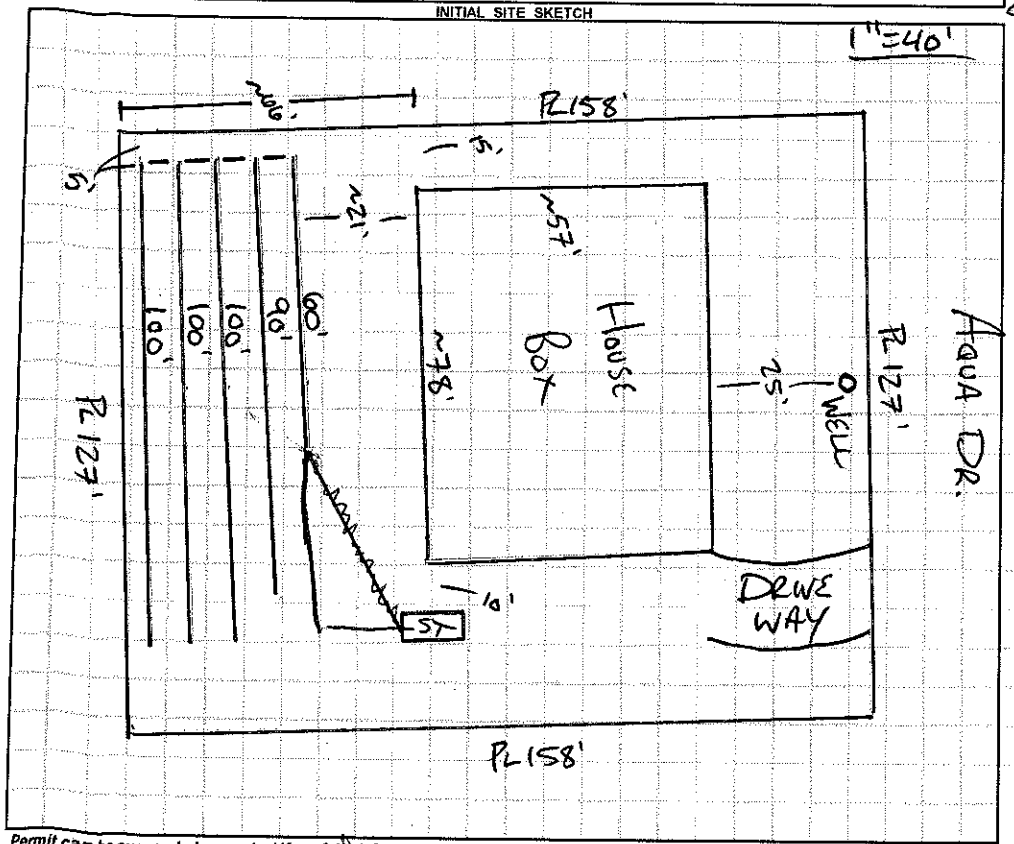

AS BUILT SKETCH

Permit can be suspended or revoked if any false information is supplied toward securing the permit / any unauthorized changes are made to the site / any unauthorized changes are made in the installation of the system. CONTACT A LOCATOR SERVICE PRIOR TO ANY EXCAVATION

☐ IMPROVEMENT PERMIT with plat valid without expiration. ☐ IMPROVEMENT PERMIT with site plan valid for 60 mos. ☒ AUTHORIZATION TO CONSTRUCT valid for period equal to IMPROVEMENT PERMIT--not to exceed 60 mo.

Owner / Applicant Signature: Date: 6/4/15 Installed by: Rowan Septic

IMPROVEMENT PERMIT by: Date: 8-3-15 OPERATION PERMIT by: Maria Lotson RS Date: 11/16/15

AUTHORIZATION TO CONSTRUCT by: Date: 8-3-15 Existing System Inspected by: Date:

Health Dept. Copy - WHITE Applicant (Final Approval) - YELLOW Applicant (Conditional Approval) - PINK