IREDELL COUNTY HEALTH DEPARTMENT

AUTHORIZATION TO CONSTRUCT

2nd

STATESVILLE 704-878-5305 MOORESVILLE 704-664-5281

IMPROVEMENT PERMIT / ~~CERTIFICATE OF COMPLETION~~ / OPERATION PERMIT / EXISTING SYSTEM INSPECTION

PROPERTY DESCRIPTION NO. 25077 DATE 10/25/96 TAX MAP NO. 2B-1-C-15 Watershed: ☑ Yes ☐ No

OWNER OR CONTRACTOR DOUG WALDO ~~PHONE: Business~~ ~~4635-80-1684~~ Home 364-1700

ADDRESS 6816 MORRISON BLVD. CHARLOTTE 28211 4635-90-15066

LOCATION LANDTREE RD - 1 MI ON RT - ACROSS FROM KINGS LANDING

SUBDIVISION LAKEVIEW SHORES BLOCK / SECTION ____ LOT 15 LOT AREA .146 AC SITE CLASS PS DESIGN FLOW 360 GPD L.T.A.R. .25 GPD/FT²

Septic Tank: 1000 Gallons; STB 794 Date 3/26/97

Pump Tank: ____ Gallons; PT ____ Date ____

Pump Make: ____ Model ____ Serial No. ____

Nitrification Field: No Fields 1 Square Feet 720 Linear Feet 240

No Lines 6@40' Trench Width 24" Max Trench Bottom Depth 30" Gravel Depth N/A

☑ New System ☐ Repair System Type: I, II, III, IV, V, VI

System Description: GRAVITY PANEL

Repair System Description: SAME

Maintenance Agreement Required: ☐ Yes ☑ No

☑ House/Mod. Home No. Bedrooms 3

☐ Mobile Home No. Bathrooms 2

☐ Business No. Employees ____

☐ Other ____


☐ Slab ☑ Crawl Space ☐ Basement w/plumbing ☐ Basement wo/plumbing

Water Supply: ☑ Individual ☐ Community ☐ Public

Comments:

Comments:

INITIAL SITE SKETCH

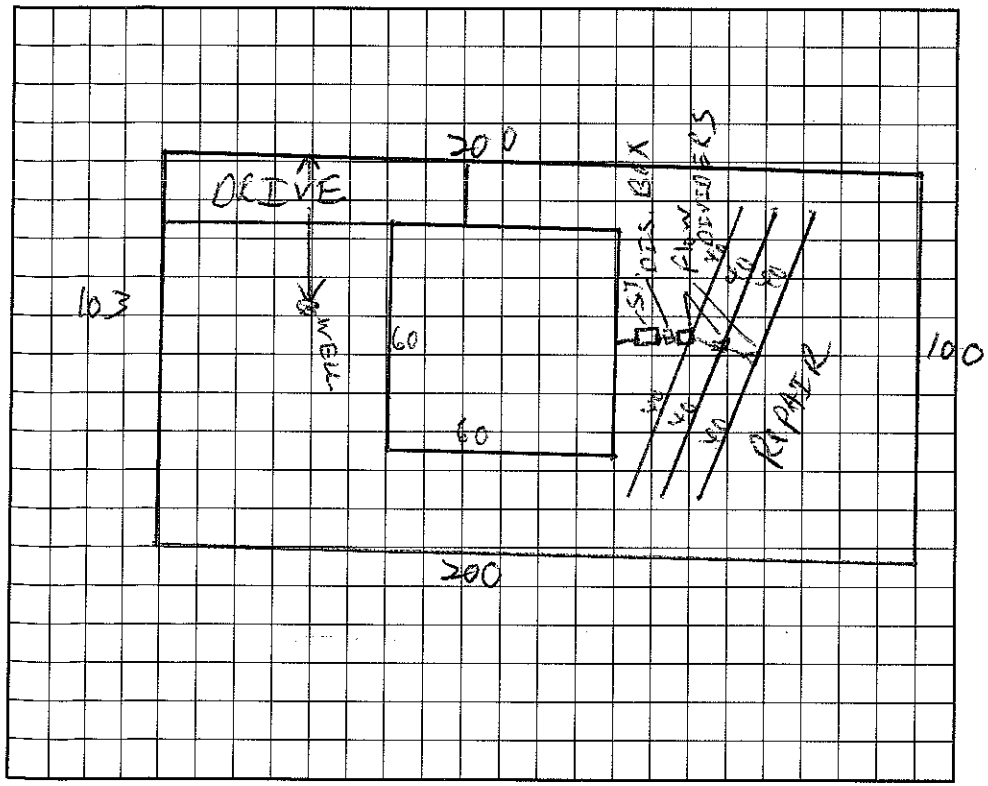

AS BUILT SKETCH

I understand that this permit can be suspended or revoked if any false information is supplied toward securing the permit/any unauthorized changes are made to the site/any unauthorized changes are made in the installation of the system.

Signed: Doug Waldo

Improvement Permit by: C. B. Thomas EHS date 10/25/96

AUTHORIZATION TO CONSTRUCT by: C. B. Thomas EHS date 10/25/96

Installed by: Doug Waldo

Certificate of Completion by: Wesley Hinkle R.S. date 6/26/97

Operation Permit by: Wesley Hinkle R.S. date 6/26/97

HEALTH DEPT. COPY: WHITE INSPECTION COPY (FINAL): GREEN OWNER COPY (FINAL): YELLOW INSPECTION COPY (INITIAL): PINK OWNER COPY (INITIAL): GOLD