BA 1.00

IREDELL COUNTY HEALTH DEPARTMENT

Statesville Office (704) 878-5305 Mooresville Office (704) 660-3625 PERMIT # 202633

IMPROVEMENT PERMIT / AUTHORIZATION TO CONSTRUCT / OPERATION PERMIT / EXISTING SYSTEM

PIN # 4635901779

APPLICANT: Rollans Soil/Richard Koch APPLICANT ADDRESS: P.O. Box 832 Mooresville, NC 28115

SITE ADDRESS: 111 Aqua Dr. Mooresville, NC 28117 PHONE: 7047466546 ALT. PHONE: 704 361-1084

SITE DIRECTIONS: Hwy 115 S. TR Langtree TR Lakeshore TL Aqua lot on left

SUBDIVISION: Lakeview Shores SJ SECTION: 2 LOT # 19 LOT AREA: .46 Ac. DESIGN FLOW: 360gpd T.A.R.: .275

Septic Tank 1000 (gal) STB 1012 Date 6-22-16
Pump Tank (gal) PT Date
Pump Make Model Serial #
Nitrification Fields 1 # Lines 5 Linear Ft: 340+
Trench Width 36" Max. Trench Bottom Depth 30" Gravel Depth N/A

☒ New System ☐ Repair ☐ Expansion System Type: I II (III) IV V VI
System Description: Gravity - 25% Reduction
Repair System Description: ☒ Repair Exempt / Partial
Maintenance Agreement Required: ☐ YES ☒ NO / PPBPS
☒ GRAVITY ☐ PRESSURE

☒ Residence ☐ Business ☐ Other ☐ Slab ☐ Basement w/plumbing
No. Bedrooms 3 No. Persons 6 No. Employees
☒ Crawl Space

Water Supply: ☒ Private ☐ Public ☐ Community ☐ Basement w/o plumbing

Comments / Conditions:

☒ Lot recorded 1963
85 Chamber 10' 4" from house to ST. Well to ST = 79ft

INITIAL SITE SKETCH

See attached, approved plan by Rollans Soil & Environmental Services, PA (dated 4-15-16)

AS BUILT SKETCH

Permit can be suspended or revoked if any false information is supplied toward securing the permit / any unauthorized changes are made to the site / any unauthorized changes are made in the installation of the system. **CONTACT A LOCATOR SERVICE PRIOR TO ANY EXCAVATION**


☐ **IMPROVEMENT PERMIT** *with plat valid without expiration.* ☐ **IMPROVEMENT PERMIT** *with site plan valid for 60 mos.* ☒ **AUTHORIZATION TO CONSTRUCT** *valid for period equal to IMPROVEMENT PERMIT--not to exceed 60 mo.*

Owner / Applicant Signature: Date: 5/11/2016 Installed by: Steve London

IMPROVEMENT PERMIT by: Maria Soto RS Date: 5/3/16 OPERATION PERMIT by: Maria Soto RS Date: 12/20/16

AUTHORIZATION TO CONSTRUCT by: Maria Soto RS Date: 5/3/16 Existing System Inspected by: Date:

Health Dept. Copy - WHITE Applicant (Final Approval) - YELLOW Applicant (Conditional Approval) - PINK

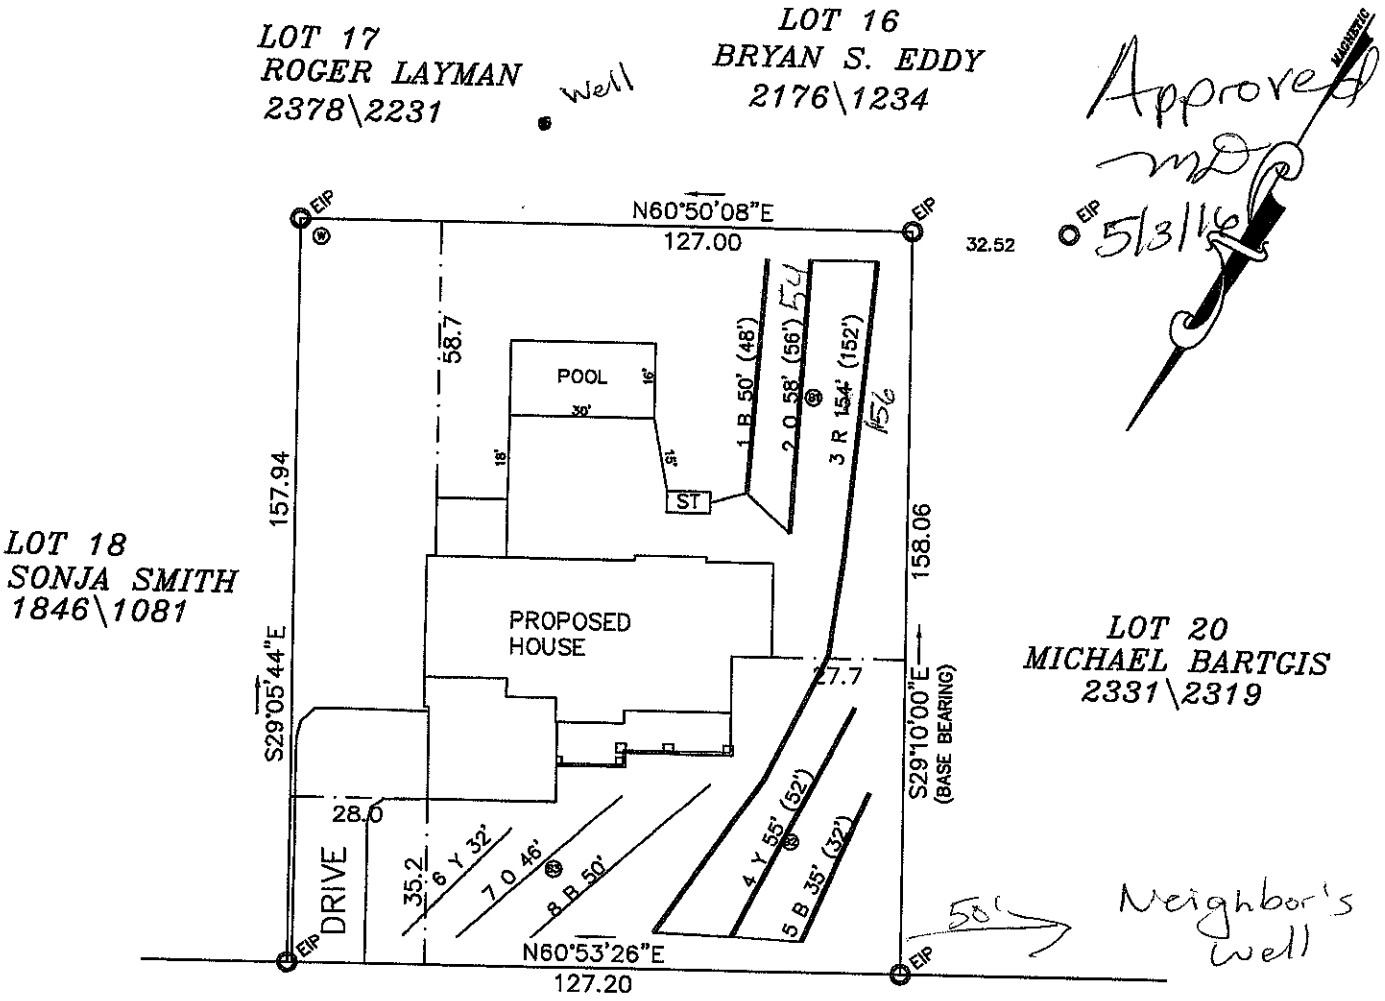

AQUA DRIVE
60' PUBLIC R/W

0' 20' 40' 100'

SCALE IN FEET