IREDELL COUNTY HEALTH DEPARTMENT

STATESVILLE 704-878-5305 MOORESVILLE 704-664-5281

IMPROVEMENT PERMIT / AUTHORIZATION TO CONSTRUCT / OPERATION PERMIT / EXISTING SYSTEM INSPECTION

PERMIT# 072753 PIN# ~~4635-81-2141~~ 4635-90-2641 DATE 5/15/98

OWNER OR CONTRACTOR RAY SHORT PHONE: Business Home

ADDRESS 470 STUTTS RD. MOORESVILLE NC 28115

LOCATION LANGTREE - ON RT PAST LAKEVIEW SHORES OR.

SUBDIVISION LAKEVIEW SHORES BLOCK / SECTION — LOT 16 LOT AREA 20,000ft² SITE CLASS. RS DESIGN FLOW 360 GPD L.T.A.R. .25 GPD/FT²

Septic Tank: 1000 Gallons; STB 794 Date 5/14/98
Pump Tank: Gallons; PT Date
Pump Make: Model Serial No.
Nitrification Field: No Fields 1 Square Feet 1050 Linear Feet 350
No Lines 5@70' Trench Width 36" Max Trench Bottom Depth 36" Gravel Depth N/A

☑ New System ☐ Repair System Type: I, II, (III), IV, V, VI
System Description: GRAVITY CHAMBERS OR HOS
Repair System Description: GRAVITY PANEL
Maintenance Agreement Required: ☐ Yes ☑ No


☑ House/Mod. Home No. Bedrooms 3
☐ Mobile Home No. Bathrooms 3
☐ Business No. Employees
☐ Other
☐ Slab ☑ Crawl Space ☐ Basement w/plumbing ☐ Basement wo/plumbing

Water Supply: ☑ Individual ☐ Public ☐ Community


Comments:/Conditions:

Comments:/Conditions:

INITIAL SITE SKETCH 1" = 40'

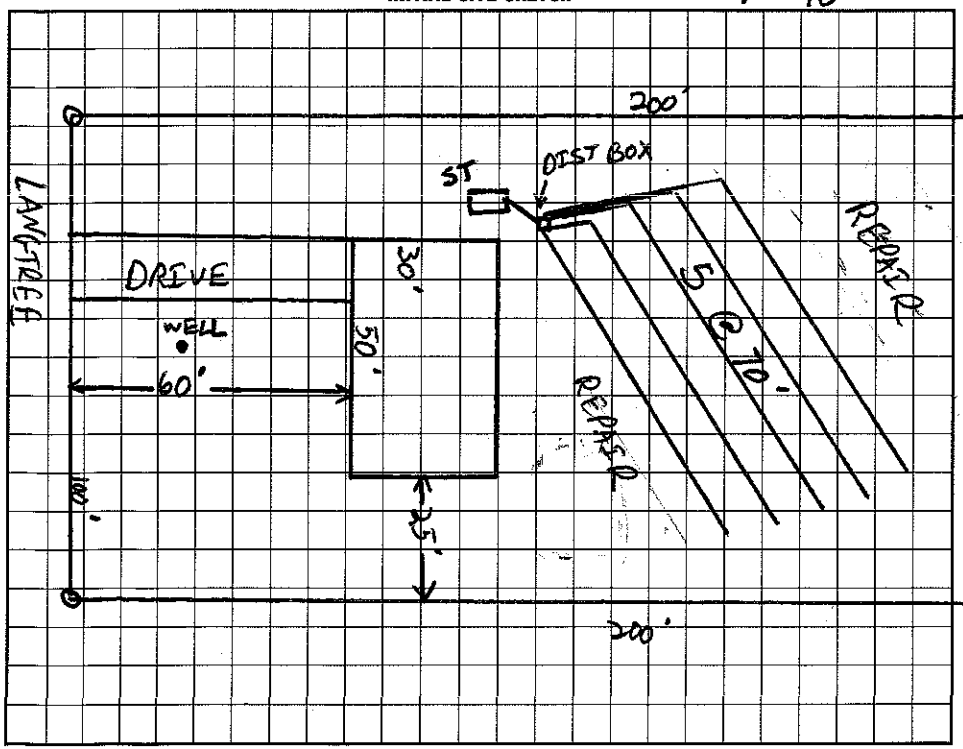

AS BUILT SKETCH

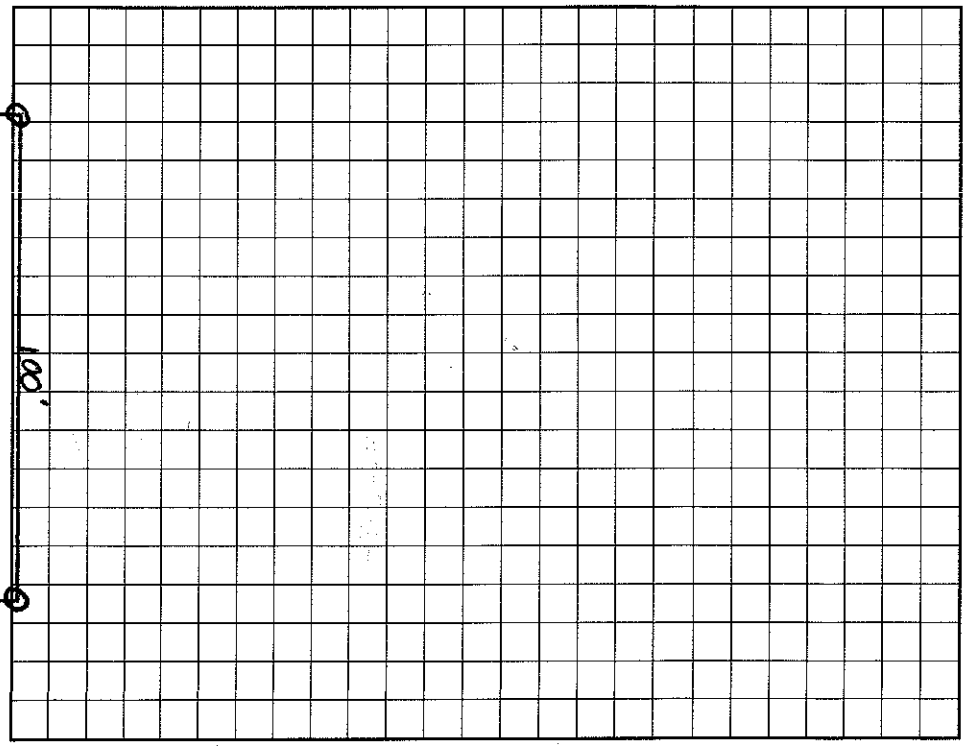

I understand that this permit can be suspended or revoked if any false information is supplied toward securing the permit/any unauthorized changes are made to the site/any unauthorized changes are made in the installation of the system. Improvement Permit with plat valid without expiration. Improvement Permit with site plan valid for sixty months. Authorization to Construct is valid for a period equal to that of Improvement Permit – not to exceed sixty months.

Signed: Ray Short date 5/18/98
Improvement Permit by: C. Ray Stutts RS date 5/14/98
Authorization to Construct by: C. Ray Stutts RS date 5/14/98

Installed by: FS ERVIN
Operation Permit by: C. Ray Stutts date 5/18/98
Existing System Inspection by: date

HEALTH DEPT. COPY: WHITE INSPECTION COPY (FINAL): GREEN OWNER COPY (FINAL): YELLOW INSPECTION COPY (INITIAL): PINK OWNER COPY (INITIAL): GOLD