IREDELL COUNTY HEALTH DEPARTMENT

Authorization To Construct

STATESVILLE 704-878-5305 MOORESVILLE 704-664-5281

9:30 - 10:00

IMPROVEMENT PERMIT / ~~CERTIFICATE OF COMPLETION~~ / OPERATION PERMIT / EXISTING SYSTEM INSPECTION

PROPERTY DESCRIPTION NO. 067852 DATE 9/11/97 TAX MAP NO. 4635904157 Watershed: X Yes

OWNER OR CONTRACTOR Timothy T Durrett PHONE: Business Home 895-0340

ADDRESS 104 Southhaven Dr. Mooresville, NC. 28115

LOCATION Langtree Rd TL 2nd Knobview Ln. first on R past Kings Crest Dr.

SUBDIVISION Kingsbending BLOCK / SECTION LOT 31 LOT AREA .65 SITE CLASS. P.S DESIGN FLOW 360 L.T.A.R. .25

Septic Tank: 1000 Gallons; STB 312 Date 2-19-00

Pump Tank: 1000 Gallons; PT 27 Date 5-7-00

Pump Make: Goulds Model WE05L1H Serial No. F002790

Nitrification Field; No Fields 1 Square Feet 1080 Linear Feet 360

No Lines 4 Trench Width 36" Max Trench Bottom Depth 30"

X New System ☐ Repair System Type: I, II, III, IV, V, VI

System Description: Pres Manifold - CHPLASTIC

Repair System Description: OR H.D.S.

Maintenance Agreement Required: ☐ Yes X No

Gravel Depth SAND.

X House/Mod. Home No. Bedrooms 3

☐ Mobile Home No. Bathrooms 3

☐ Business No. Employees

☐ Other


☐ Slab X Crawl Space ☐ Basement w/plumbing ☐ Basement wo/plumbing

Water Supply: ☐ Individual X Community ☐ Public

Comments: * Chambered Plastic or H.D.S.
Pump 29GPM - 162GAL/DOSE

Comments: Installed as Drawn
Tanks, lines & pressure checked 7/27/2000
Filter & riser installed.
Need alarm & elect.

INITIAL SITE SKETCH

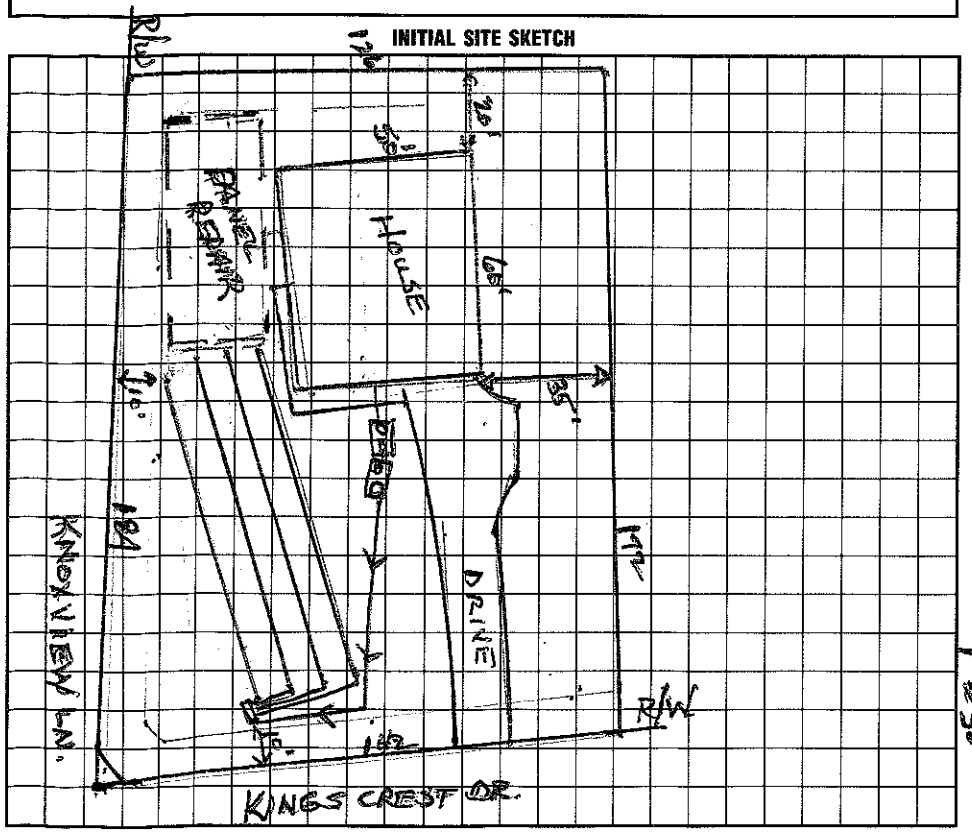

AS BUILT SKETCH

I understand that this permit can be suspended or revoked if any false information is supplied toward securing the permit/any unauthorized changes are made to the site/any unauthorized changes are made in the installation of the system. Improvement Permit is valid for 60 months from date of issuance.

Signed: * Timothy T Durrett

Improvement Permit by: Wesley Sparks RS. date 9/11/97

Existing System Inspection by: Wesley Sparks RS. date 9/11/97

Installed by: F.J. Ervin

Certificate of Completion by: Marshall A. Dotson 9/22/00

Operation Permit by: date

HEALTH DEPT. COPY: WHITE INSPECTION COPY (FINAL): GREEN OWNER COPY (FINAL): YELLOW INSPECTION COPY (INITIAL): PINK OWNER COPY (INITIAL): GOLD