IREDELL COUNTY HEALTH DEPARTMENT

Authorization to Construct

STATESVILLE 704-878-5305 MOORESVILLE 704-664-5281

IMPROVEMENT PERMIT / ~~CERTIFICATE OF COMPLETION~~ / OPERATION PERMIT / EXISTING SYSTEM INSPECTION

PROPERTY DESCRIPTION NO. 26323 DATE 3/24/97 TAX MAP NO. 4635905581 Watershed: X Yes ☐ No

OWNER OR CONTRACTOR Ken Anson PHONE: Business 522-4884 Home WS N CA

ADDRESS Castle Ct. Mooresville, NC 28115

LOCATION Langtree Rd. TL 2nd Knoxview TL Castle Ct, 1st lot on (L) - Corner lot

SUBDIVISION Kingsbridge BLOCK / SECTION LOT 41 LOT AREA ~30,000 FT² SITE CLASS. PS DESIGN FLOW 480 L.T.A.R. .3

Septic Tank: ~~1000~~ 1500 Gallons; STB 747 Date 5/23/97

Pump Tank: ~~1000~~ 1000 Gallons; PT 27 Date 5/19/97

Pump Make: GOULDS Model WE05 1IH Serial No. F97H717

Nitrification Field: No Fields 1 Square Feet 1200* Linear Feet 400*

No Lines 4 Trench Width 36" Max Trench Bottom Depth 36" Gravel Depth SAND

X New System ☐ Repair System Type: I, II, III, IV, V, VI

System Description: X-Pres Mon - CH. PLASTIC

Repair System Description: 1½" PBS

Maintenance Agreement Required: ☐ Yes ☐ No

X House/Mod. Home No. Bedrooms 4

☐ Mobile Home No. Bathrooms 3

☐ Business No. Employees ___

X Other GARDISP


☐ Slab X Crawl Space ☐ Basement w/plumbing ☐ Basement wo/plumbing

Water Supply: ☐ Individual X Community ☐ Public


Comments: X 25% Reduction for CH PLASTIC USE

Comments: PRESSURE, TANKS, LINES CHECKED 7/8/97

INITIAL SITE SKETCH

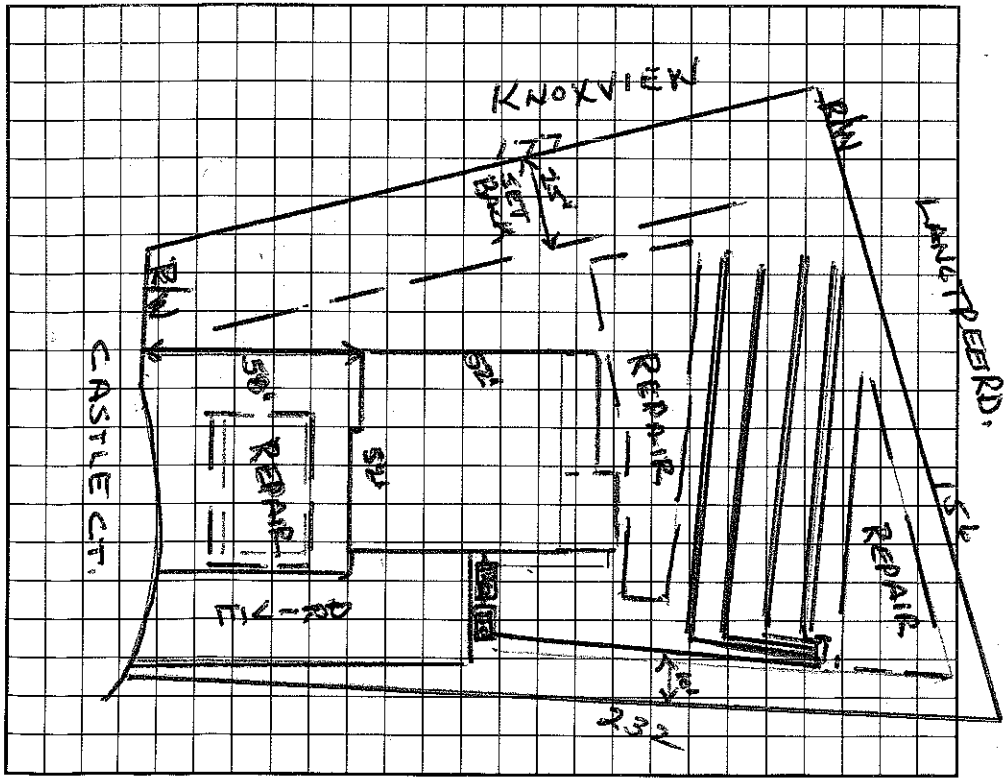

AS BUILT SKETCH

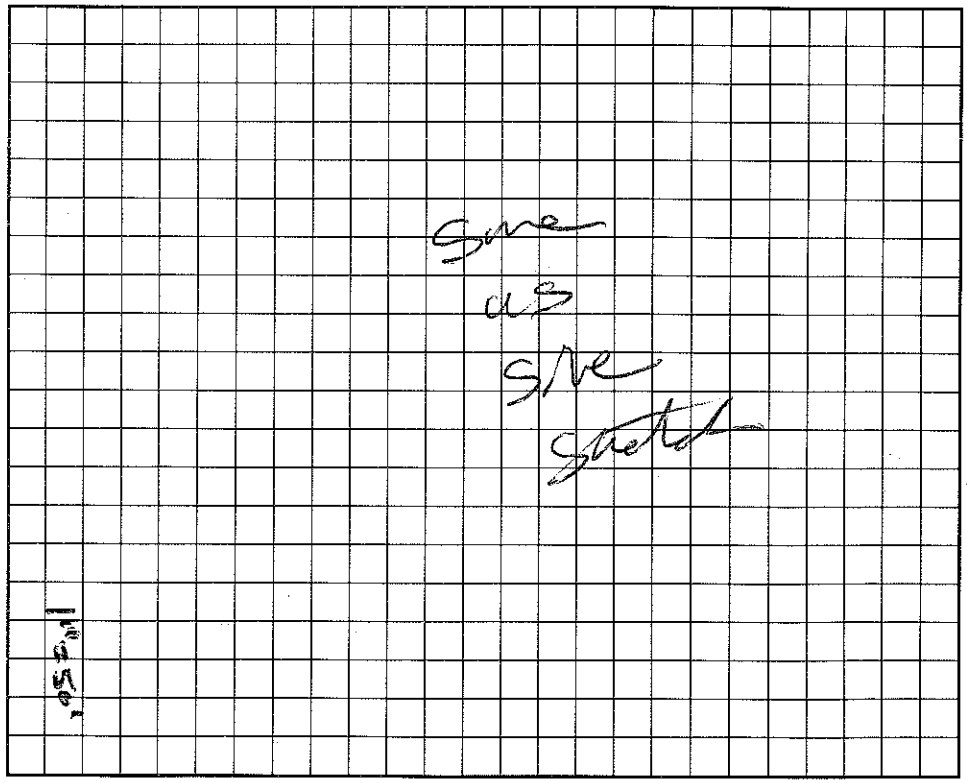

I understand that this permit can be suspended or revoked if any false information is supplied toward securing the permit/any unauthorized changes are made to the site/any unauthorized changes are made in the installation of the system. Improvement Permit is valid for 60 months from date of issuance.

Signed: X 3.26.97

Improvement Permit by: Wesley Sparks R.S. date 3/24/97

Existing System Inspection by: Wesley Sparks R.S. date 3/24/97

Installed by: FJ BOWEN

Certificate of Completion by: Wesley Sparks R.S. date 7/9/97

Operation Permit by: Wesley Sparks R.S. date 7/9/97

Authorization to Construct

HEALTH DEPT. COPY: WHITE INSPECTION COPY (FINAL): GREEN OWNER COPY (FINAL): YELLOW INSPECTION COPY (INITIAL): PINK OWNER COPY (INITIAL): GOLD