IREDELL COUNTY HEALTH DEPARTMENT

STATESVILLE 704-878-5305 130.00 Paid MOORESVILLE 704-664-5281 13

IMPROVEMENT PERMIT / AUTHORIZATION TO CONSTRUCT / [illegible]ATION PERMIT / EXISTING SYSTEM INSPECTION

PERMIT# 126646 PIN# ~~4635 90 5916~~ ~~4635-80-9855~~ 4635-90-5916 DATE 3/8/05

OWNER OR CONTRACTOR Traditional Southern Homes LLC PHONE: Business 980-721-5434 Home

ADDRESS 8533 Glade Ct Huntersville NC 28078

LOCATION Langtree, TR 1st Lake Shore, 2nd on Rt.

SUBDIVISION LakeView Shores BLOCK / SECTION D LOT 23 LOT AREA 0.46Ac SITE CLASS. PS DESIGN FLOW 480 L.T.A.R. 0.3

Septic Tank: 1000 Gallons; STB 794 Date 6/22/05

Pump Tank: Gallons; PT Date

Pump Make: Model Serial No.

Nitrification Field: No Fields 1 Square Feet 810# Linear Feet 270'

No Lines 6@45' Trench Width 24" 8FOC Max Trench Bottom Depth 36" Gravel Depth —

☒ New System ☐ Repair System Type: I, II, (III), IV, V, VI

System Description: Gravity Panel Black

Repair System Description: LP Panel Black

Maintenance Agreement Required: ☐ Yes ☒ No

☒ House/Mod. Home No. Bedrooms 4

☐ Mobile Home No. Bathrooms

☐ Business No. Employees

☐ Other

☐ Slab ☒ Crawl Space ☐ Basement w/plumbing ☐ Basement wo/plumbing


Water Supply: ☒ Individual ☐ Public ☐ Community

Comments:/Conditions: OR 36" 9FOC


1"=40'

Comments:/Conditions:

INITIAL SITE SKETCH

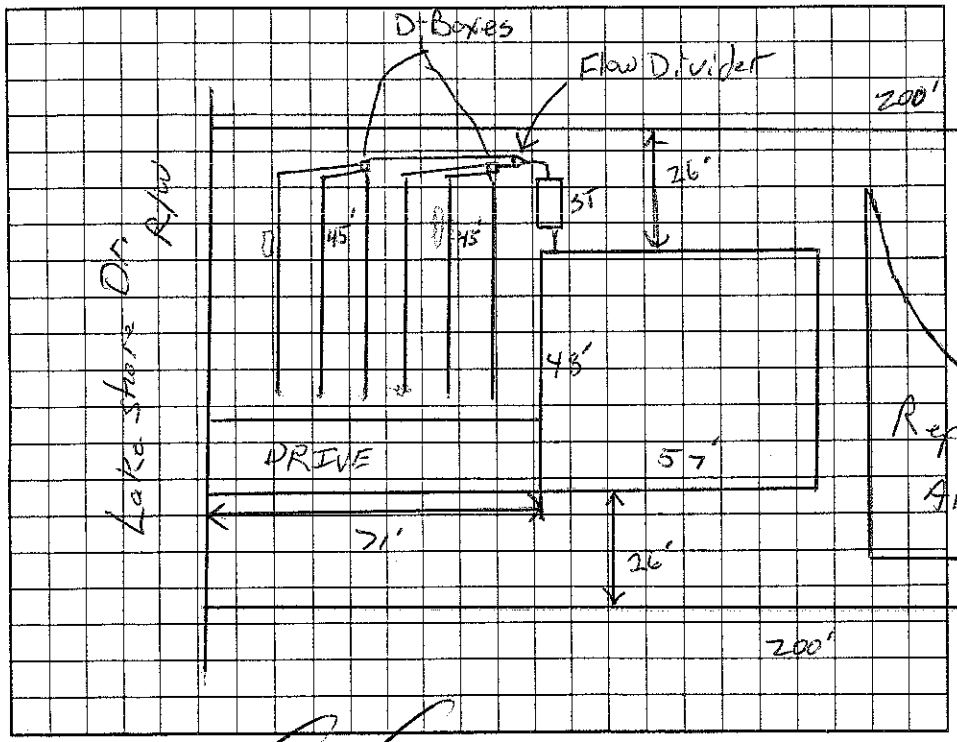

AS BUILT SKETCH

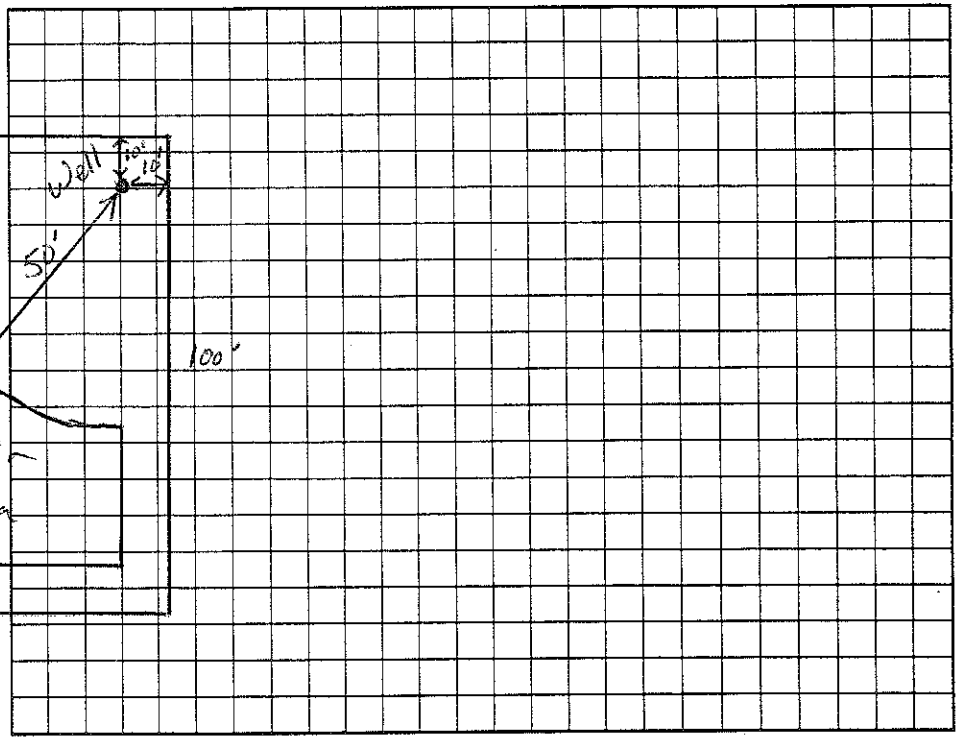

Permit can be suspended or revoked if any false information is supplied toward securing the permit/any unauthorized changes are made to the site/any unauthorized changes are made in the installation of the system. Improvement Permit with plat valid without expiration. Improvement Permit with site plan valid for sixty months. Authorization to Construct is valid for a period equal to that of Improvement Permit – not to exceed sixty months.

Signed: date 3-11-05 Installed by: Gerald Tucker

Improvement Permit by: RS date 3/8/05 Operation Permit by: Judy Melville date 8-3-05

Authorization to Construct by: RS date 3/8/05 Existing System Inspection by: date

HEALTH DEPT. COPY: WHITE OWNER COPY (FINAL): YELLOW OWNER COPY (INITIAL): PINK