...WELL COUNTY HEALTH DEPARTMENT Use ...tion to Construct (300)

STATESVILLE 704-878-5305 MOORESVILLE 704-664-5281

IMPROVEMENT PERMIT / ~~CERTIFICATE OF COMPLETION~~ / OPERATION PERMIT / EXISTING SYSTEM INSPECTION

PROPERTY DESCRIPTION NO. 23937 DATE 5/20/96 TAX MAP NO. 2B 5B 46 Watershed: [X] Yes [ ] No

OWNER OR CONTRACTOR C R Dobson Builders PHONE: Business 548-0067 ~~Home~~ 4635-90-6190

ADDRESS 8220 Univ. Exec. Park. Charlotte, NC 28205

LOCATION Langtree Rd TL 2.50 Knox Acres, 2ND lot on (L) after Castle Ct.

SUBDIVISION KINGSLANDING BLOCK / SECTION 1 LOT 46 LOT AREA .56 AC SITE CLASS PS DESIGN FLOW 480 L.T.A.R. .3

Septic Tank: 1000 Gallons; STB 794 Date 3/12/97

Pump Tank: _____ Gallons; PT _____ Date _____

Pump Make: _____ Model _____ Serial No. _____

Nitrification Field: No Fields 1 Square Feet 1920 Linear Feet ~~640~~ (480)

No Lines 8 Trench Width 36" Max Trench Bottom Depth 32" Gravel Depth SAND

[X] New System [ ] Repair System Type: I, II, (III), IV, V, VI

System Description: Ch Plastic - Flow Divider

Repair System Description: Pres. Ch Plastic

Maintenance Agreement Required: [ ] Yes [ ] No

[X] House/Mod. Home No. Bedrooms 4

[ ] Mobile Home No. Bathrooms 3

[ ] Business No. Employees ____

[ ] Other ____


[ ] Slab [X] Crawl Space [ ] Basement w/plumbing [ ] Basement wo/plumbing

Water Supply: [ ] Individual [X] Community [ ] Public


Comments: * 25% reduction for Chem. Plastic

Comments:

INITIAL SITE SKETCH

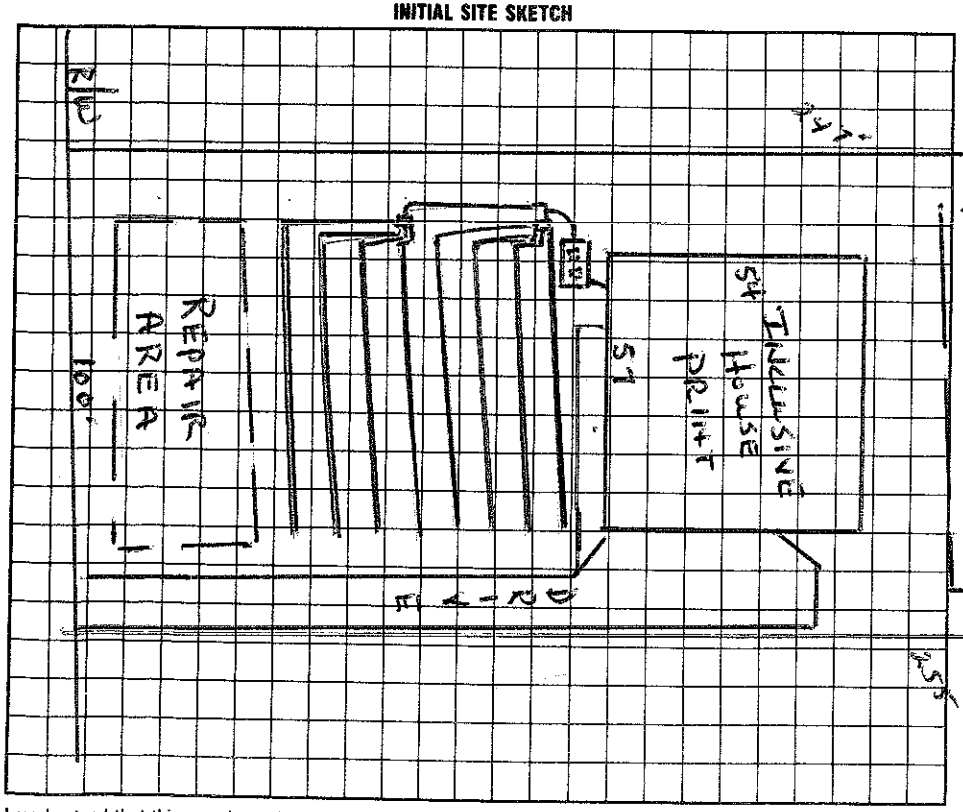

AS BUILT SKETCH

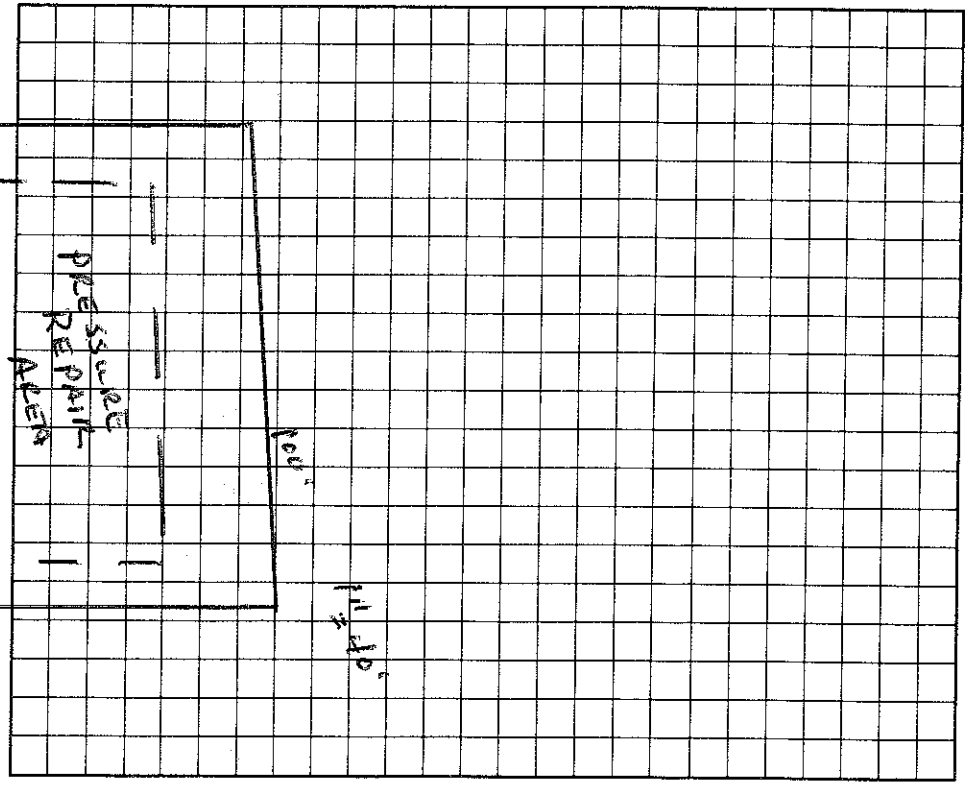

I understand that this permit can be suspended or revoked if any false information is supplied toward securing the permit/any unauthorized changes are made to the site/any unauthorized changes are made in the installation of the system.

Signed: X [signature]

Improvement Permit by: Wesley Hankins RS. date 5/4/96

Existing system inspection by: Wesley Hankins RS. date 5/21/96

Installed by: MAYHEW SEPTIC

Certificate of Completion by: _____ date _____

Operation Permit by: [signature] date 6/19/97

HEALTH DEPT. COPY: WHITE INSPECTION COPY (FINAL): GREEN OWNER COPY (FINAL): YELLOW INSPECTION COPY (INITIAL): PINK OWNER COPY (INITIAL): GOLD