IREDELL COUNTY HEALTH DEPARTMENT

STATESVILLE 704-878-5305 MOORESVILLE 704-664-5281

130.00 Paid 11 00

IMPROVEMENT PERMIT / AUTHORIZATION TO CONSTRUCT / OPERATION PERMIT / EXISTING SYSTEM INSPECTION

PERMIT# 113410 PIN# 4635-90-6255 DATE 7/8/03

OWNER OR CONTRACTOR James Savage PHONE: Business 704-892-5568 Home

ADDRESS 16908-L Landings Dr. Huntersville NC 28078

LOCATION 115 S, TR Langtree TL 2nd Knoxview on Lt on corner w/ Castle Bay Ct.

SUBDIVISION Kings Landing BLOCK / SECTION LOT 45 LOT AREA 0.55AC SITE CLASS. #5 DESIGN FLOW 360 L.T.A.R. 0.25

Septic Tank: 1000 Gallons; STB 794 Date 11-16-03

Pump Tank: Gallons; PT Date

Pump Make: Model Serial No.

Nitrification Field: No Fields 1 Square Feet 1080 Linear Feet 360

No Lines 4 Trench Width 36" Max Trench Bottom Depth 36" Gravel Depth —

☒ New System ☐ Repair System Type: I, II, (III) IV, V, VI

System Description: Gravity 25% Reduction

Repair System Description: LP Panel Block

Maintenance Agreement Required: ☐ Yes ☒ No

☒ House/Mod. Home ☐ Mobile Home ☐ Business ☐ Other

No. Bedrooms 3 No. Bathrooms 2½ No. Employees


Water Supply: ☐ Individual ☐ Public ☒ Community

☐ Slab ☒ Crawl Space ☐ Basement w/plumbing ☐ Basement wo/plumbing

Comments:/Conditions:

Water Line Needs to be 10' From Septic System

INITIAL SITE SKETCH

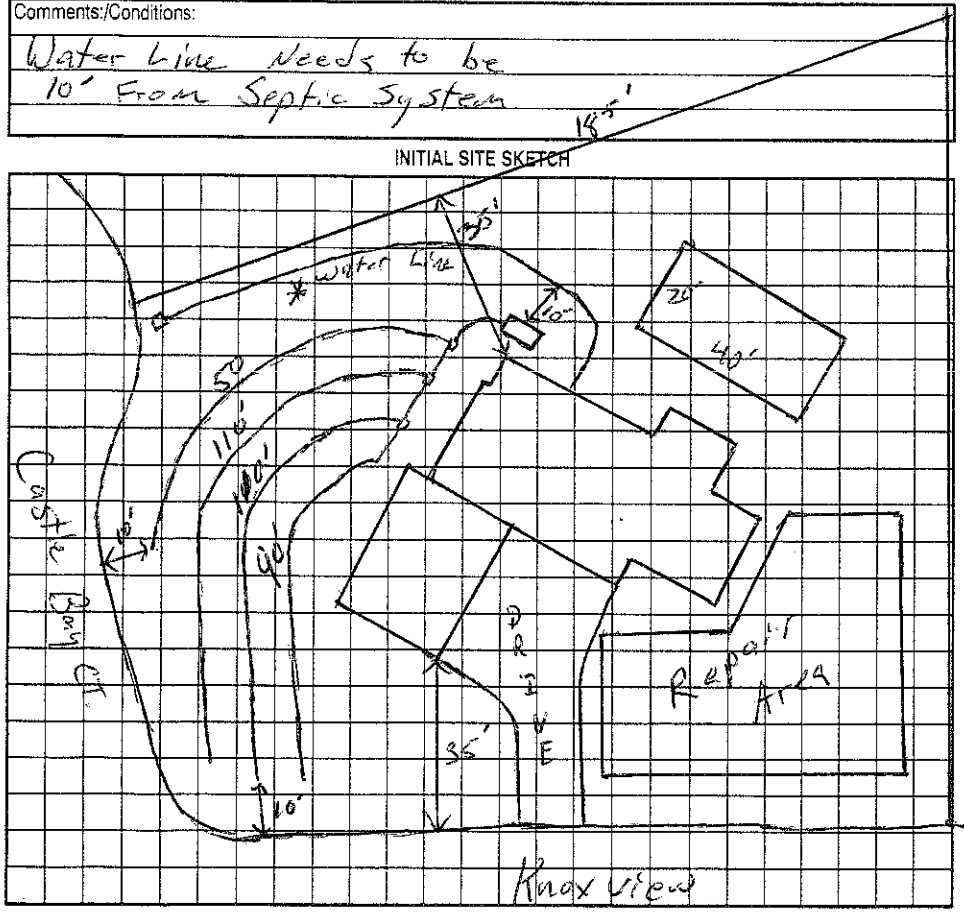

Comments:/Conditions:

AS BUILT SKETCH

167'

Permit can be suspended or revoked if any false information is supplied toward securing the permit/any unauthorized changes are made to the site/any unauthorized changes are made in the installation of the system. Improvement Permit with plat valid without expiration. Improvement Permit with site plan valid for sixty months. Authorization to Construct is valid for a period equal to that of Improvement Permit – not to exceed sixty months.

Signed: James Savage date 7/9/03 Installed by: Jackson Excavating

Improvement Permit by: RS date 7/8/03 Operation Permit by: RS date 1/5/04

Authorization to Construct by: RS date 7/8/03 Existing System Inspection by: date

HEALTH DEPT. COPY: WHITE OWNER COPY (FINAL): YELLOW OWNER COPY (INITIAL): PINK