IREDELL COUNTY HEALTH DEPARTMENT

STATESVILLE 704-878-5305 MOORESVILLE 704-664-5281

IMPROVEMENT PERMIT / CERTIFICATE OF COMPLETION / OPERATION PERMIT / EXISTING SYSTEM INSPECTION

PROPERTY DESCRIPTION NO. 21477 DATE 6/26/95 TAX MAP NO. 2B-5A 47 Watershed: [X] Yes [ ] No

OWNER OR CONTRACTOR C. Richard Dobson Blders. PHONE: Business 548-0067 Home 4635-90-7011

ADDRESS 8220 Union Executive Park Ste 130 Charlotte NC. 28262

LOCATION Langtree TL on Knoxview Ln. to 4th on (R) after intersection

SUBDIVISION Kings Landing BLOCK / SECTION 1 LOT 47 LOT AREA 2.70 SITE CLASS. P DESIGN FLOW 480 L.T.A.R. .3

Septic Tank: 1000 Gallons; STB 784 Date 3/15/96

Pump Tank: _____ Gallons; PT _____ Date _____

Pump Make: _____ Model _____ Serial No. _____

Nitrification Field: No Fields 2 Square Feet 1600 Linear Feet 525

No Lines 7 Trench Width 36" Max Trench Bottom Depth 30" Gravel Depth 12"

[X] New System [ ] Repair System Type: I (II) III, IV, V, VI

System Description: CONV - FLOW DIVIDER-D/B

Repair System Description: GRAVITY PANEL

Maintenance Agreement Required: [ ] Yes [X] No

[X] House/Mod. Home No. Bedrooms 4

[ ] Mobile Home No. Bathrooms 3

[ ] Business No. Employees _____

[ ] Other _____


[ ] Slab [X] Crawl Space [ ] Basement w/plumbing [ ] Basement wo/plumbing

Water Supply: [ ] Individual [X] Community [ ] Public


Comments: FLOW DIVIDER REQUIRED - DIST BOX
SET FOR 4 LINES UPPER - 3 LINES LOWER

Comments:

INITIAL SITE SKETCH

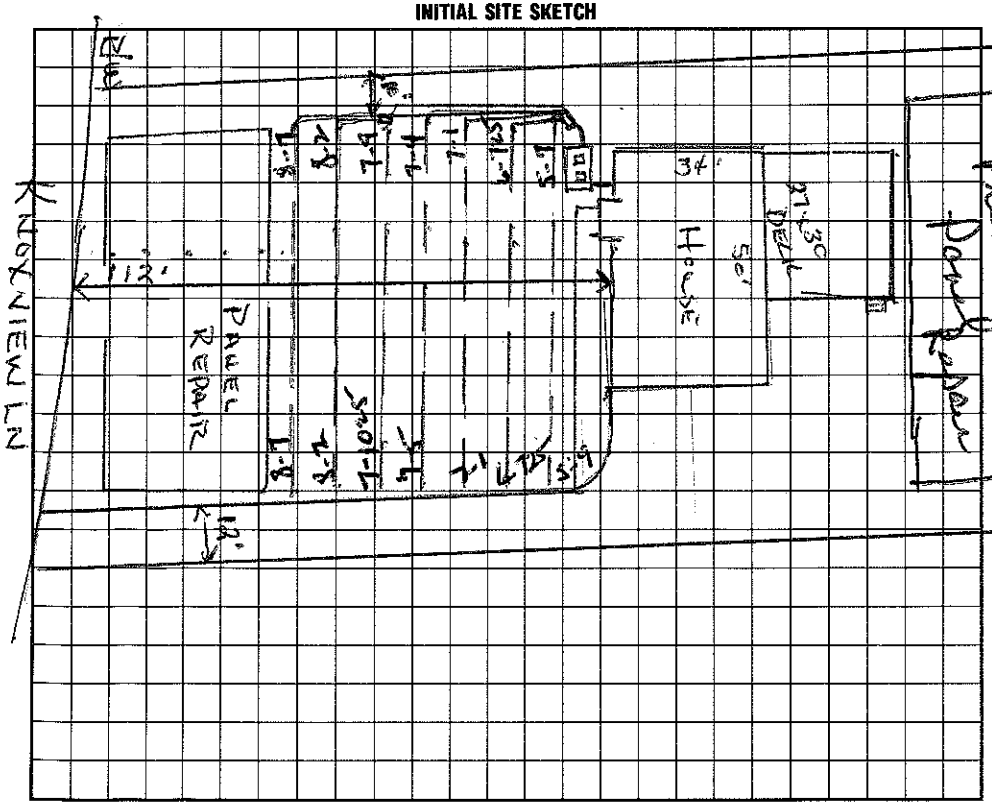

AS BUILT SKETCH

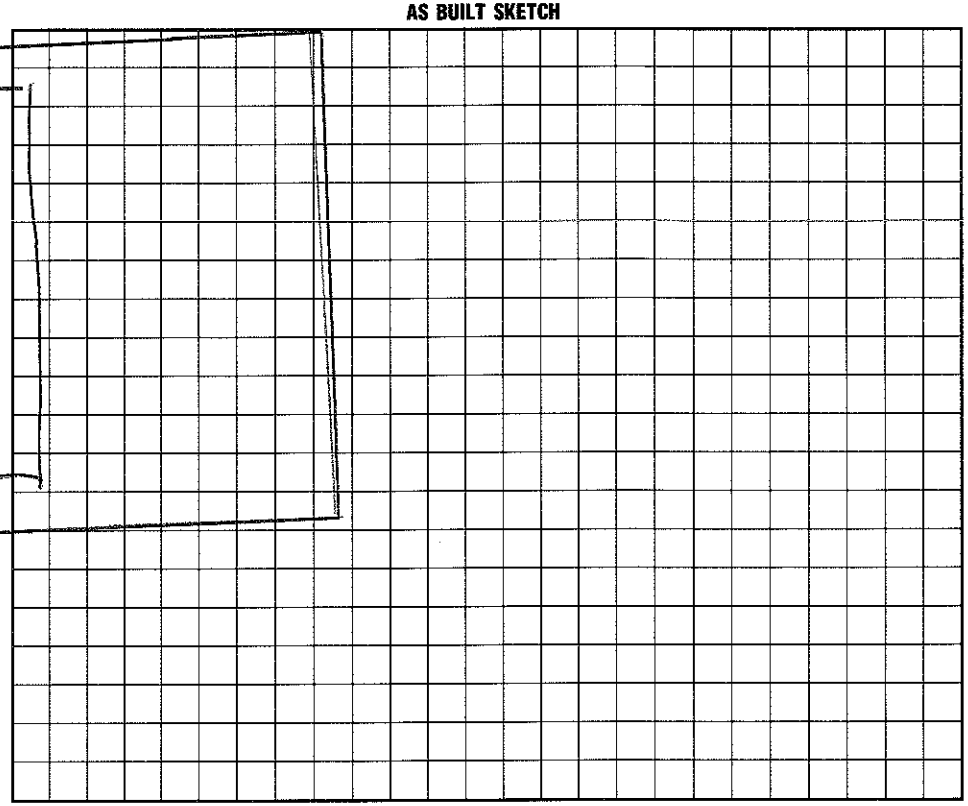

I understand that this permit can be suspended or revoked if any false information is supplied toward securing the permit/any unauthorized changes are made to the site/any unauthorized changes are made in the installation of the system. Improvement Permit is valid for 60 months from date of issuance.

Signed: _____

Improvement Permit by: Wesley Sparks RS. date 6/26/95

Existing System Inspection by: _____ date _____

Installed by: Bob Mayhew

Certificate of Completion by: _____ date _____

Operation Permit by: Wesley Sparks RS. date 6/7/96

HEALTH DEPT. COPY: WHITE INSPECTION COPY (FINAL): GREEN OWNER COPY (FINAL): YELLOW INSPECTION COPY (INITIAL): PINK OWNER COPY (INITIAL): GOLD