IREDELL COUNTY HEALTH DEPARTMENT / Intent to Construct

STATESVILLE 704-878-5305 MOORESVILLE 704-664-5281

IMPROVEMENT PERMIT / ~~CERTIFICATE OF COMPLETION~~ / OPERATION PERMIT / EXISTING SYSTEM INSPECTION

PROPERTY DESCRIPTION NO. 26264 DATE 3/24/97 TAX MAP NO. 4635907378 70 Watershed: X Yes ☐ No

OWNER OR CONTRACTOR David Nelson PHONE: Business _____ Home 845-2761 WS IV CA

ADDRESS 108 Castle Ct. Mooresville, NC.

LOCATION Longtree Rd. TL 2nd Knollview TL Castle Ct. on (R) at end of culdesac

SUBDIVISION Kingslanding BLOCK / SECTION _____ LOT 44 LOT AREA ~25000Ft² SITE CLASS. PS I DESIGN FLOW 480 L.T.A.R. .3

Septic Tank: ~~1250~~ 1500 Gallons; STB 791 Date 5/24/97 X New System ☐ Repair System Type: I, II, III, IV, V, VI

Pump Tank: _____ Gallons; PT _____ Date _____ System Description: Gravity - 16" PPBS

Pump Make: _____ Model _____ Serial No. _____ Repair System Description: Pressure - 16" PPBS

Nitrification Field: No Fields 1 Square Feet ~~540~~ Linear Feet ~~270~~ Maintenance Agreement Required: ☐ Yes X No

No Lines 3 Trench Width 24" Max Trench Bottom Depth 36" Gravel Depth SAND ☐ Slab X Crawl Space ☐ Basement w/plumbing ☐ Basement wo/plumbing

X House/Mod. Home No. Bedrooms 4

☐ Mobile Home No. Bathrooms 4

☐ Business No. Employees _____


X Other GARAGE DISP.

Water Supply: ☐ Individual X Community ☐ Public

Comments: ~~X~~ 50% reduction for PPBS use.

Comments: 11/4/08 Proposed addition or garage basement appears to impact drainfield or repair area. W Sparks RS.

INITIAL SITE SKETCH

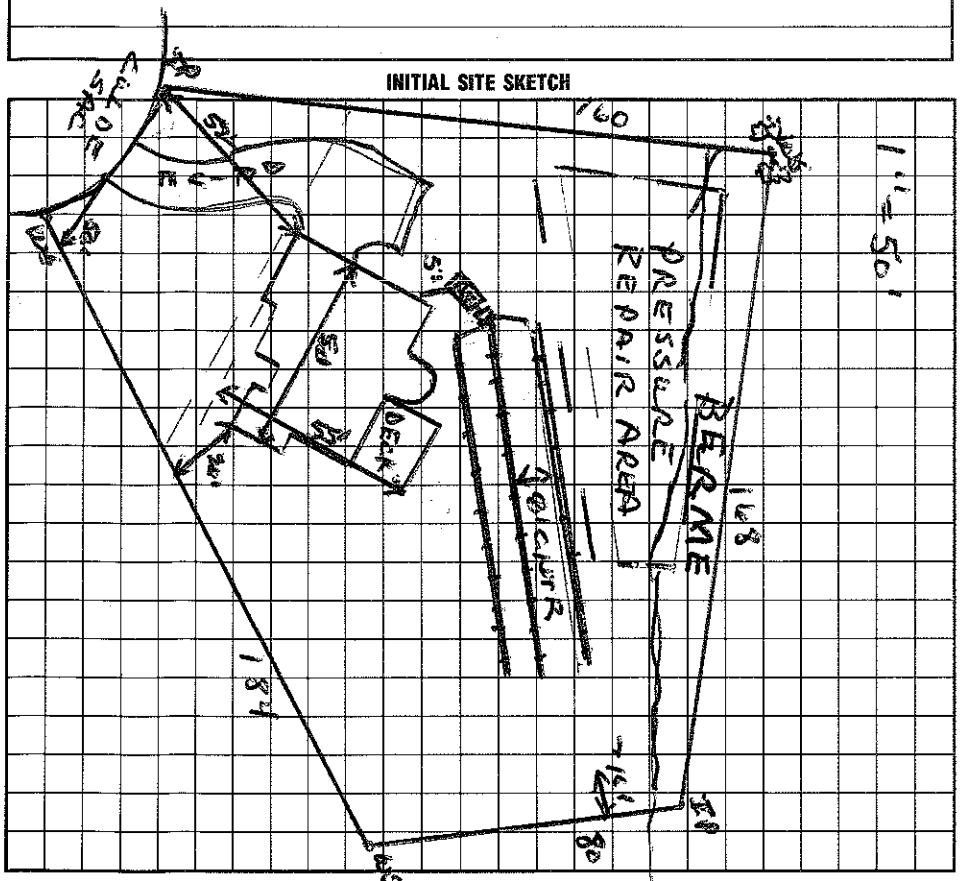

AS BUILT SKETCH

I understand that this permit can be suspended or revoked if any false information is supplied toward securing the permit/any unauthorized changes are made to the site/any unauthorized changes are made in the installation of the system. Improvement Permit is valid for 60 months from date of issuance.

Signed: ~~X~~ 3.26.97

Improvement Permit by: Wesley Sparks RS. date 3/24/97

Existing System Inspection by: Wesley Sparks RS. date 3/24/97

Installed by: F J Ervin

Certificate of Completion by: Wesley Sparks RS. date 7/10/97

Operation Permit by: Wesley Sparks RS. date 7/16/97

Accepted

HEALTH DEPT. COPY: WHITE INSPECTION COPY (FINAL): GREEN OWNER COPY (FINAL): YELLOW INSPECTION COPY (INITIAL): PINK OWNER COPY (INITIAL): GOLD