IREDELL COUNTY HEALTH DEPARTMENT

AUTHORIZATION TO CONSTRUCT

STATESVILLE 704-878-5305 MOORESVILLE 704-664-5287

4.00

IMPROVEMENT PERMIT / ~~CERTIFICATE OF COMPLETION~~ / OPERATION PERMIT / EXISTING SYSTEM INSPECTION

PROPERTY DESCRIPTION NO. 26122 DATE 4/2/97 TAX MAP NO. 4635907525 Watershed: ☐ Yes ☐ No

OWNER OR CONTRACTOR PAT + BECKY CRONIN PHONE: Business _____ Home 872-7374

ADDRESS 110 CLAREMONT WAY MOORESVILLE

LOCATION LANTREE RD - TL KNOXVIEW - TL FIRST RD (CASTLE LN) - ON LEFT

SUBDIVISION KINGS LANDING BLOCK / SECTION _____ LOT 42 LOT AREA _____ SITE CLASS. PS DESIGN FLOW 480 GPD L.T.A.R. .36 GPD/FT

Septic Tank: 1000 Gallons; STB 1012 Date 12/10/97

Pump Tank: _____ Gallons; PT _____ Date _____

Pump Make: _____ Model _____ Serial No. _____

Nitrification Field: No Fields 1 Square Feet 1605 Linear Feet 535

No Lines 5 @ 107' Trench Width 36" Max Trench Bottom Depth 30" Gravel Depth 12"

☑ New System ☐ Repair System Type: I, II, III, IV, V, VI

System Description: GRAVITY CONVENTIONAL

Repair System Description: GRAVITY CHAMBERED

Maintenance Agreement Required: ☐ Yes ☒ No

☑ House/Mod. Home No. Bedrooms 4

☐ Mobile Home No. Bathrooms 4

☐ Business No. Employees _____

☐ Other _____


☐ Slab ☑ Crawl Space ☐ Basement w/plumbing ☐ Basement wo/plumbing

Water Supply:
☐ Individual
☑ Community
☐ Public


Comments:

Comments:

INITIAL SITE SKETCH

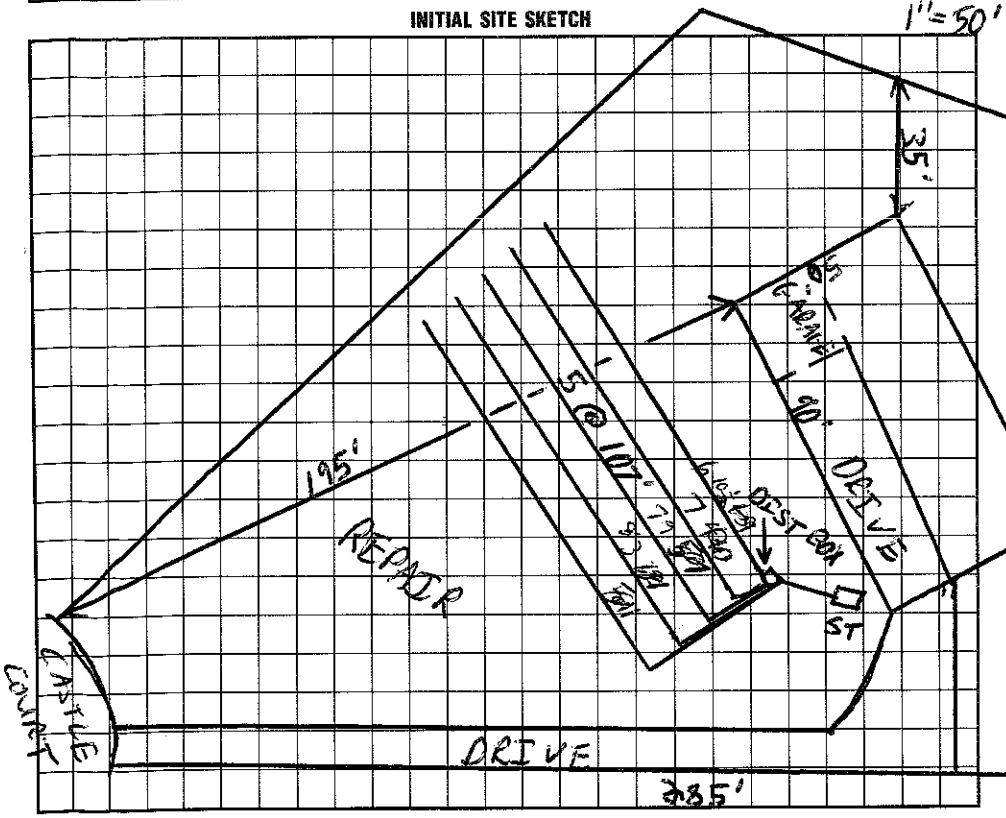

AS BUILT SKETCH

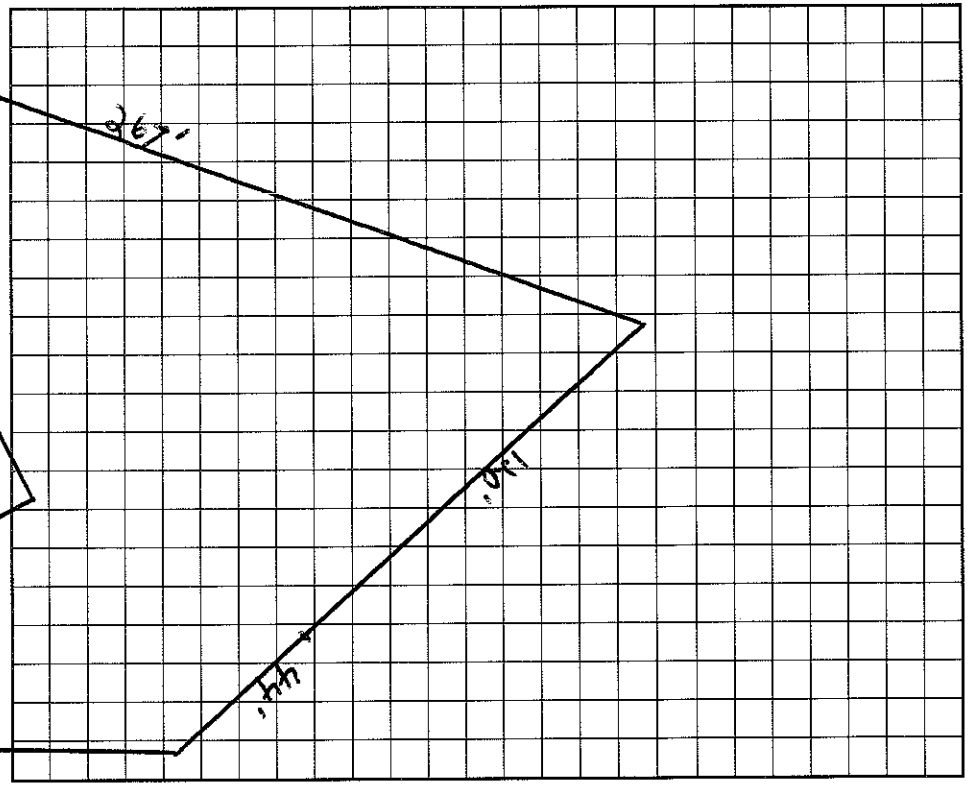

I understand that this permit can be suspended or revoked if any false information is supplied toward securing the permit/any unauthorized changes are made to the site/any unauthorized changes are made in the installation of the system. Improvement Permit is valid for 60 months from date of issuance.

Signed: Richard A. Abernathy

Installed by: RICHARD ABERNATHY

Improvement Permit by: C. Ray Teem EHSI date 4/2/97

AUTHORIZATION Existing System Inspection by: C. Ray Teem EHSI date 4/2/97

Certificate of Completion by: _____ date _____

Operation Permit by: C. Ray Teem date 3/24/98

CONSTRUCT

HEALTH DEPT. COPY: WHITE INSPECTION COPY (FINAL): GREEN OWNER COPY (FINAL): YELLOW INSPECTION COPY (INITIAL): PINK OWNER COPY (INITIAL): GOLD