IREDELL COUNTY HEALTH DEPARTMENT

STATESVILLE 704-878-5305 MOORESVILLE 704-664-5281

IMPROVEMENT PERMIT / AUTHORIZATION TO CONSTRUCT / OPERATION PERMIT / EXISTING SYSTEM INSPE

PERMIT# 077809 PIN# 4635908415 DATE 11/5/98

OWNER OR CONTRACTOR KURT KARNATZ PHONE: Business Home 896-7476

ADDRESS 107 CLAREMONT MOORESVILLE NC 28115

LOCATION LANG-TREE RD - TL 2nd KNOX VIEW - TL CASTLE COURT - IN CUL-DE-SAC

SUBDIVISION KINGS LANDING BLOCK / SECTION LOT 43 LOT AREA .65AC SITE CLASS. RS DESIGN FLOW 360GPD L.T.A.R. .38PD/FR

Septic Tank: 1000 Gallons; STB 312 Date

Pump Tank: Gallons; PT Date

Pump Make: Model Serial No.

Nitrification Field: No Fields 1 Square Feet 400 Linear Feet 200

No Lines 6 Trench Width 24" Max Trench Bottom Depth 36" Gravel Depth N/A

☑ New System ☐ Repair System Type: I, II, III, IV, V, VI

System Description: GRAVITY PANEL

Repair System Description: PUMP PANEL

Maintenance Agreement Required: ☐ Yes ☑ No

☑ House/Mod. Home No. Bedrooms 3

☐ Mobile Home No. Bathrooms 3

☐ Business No. Employees

☐ Other


☐ Slab ☐ Crawl Space ☐ Basement w/plumbing ☐ Basement wo/plumbing

Water Supply: ☑ Individual ☐ Public ☐ Community


Comments:/Conditions:

Comments:/Conditions:

INITIAL SITE SKETCH 1"=50'

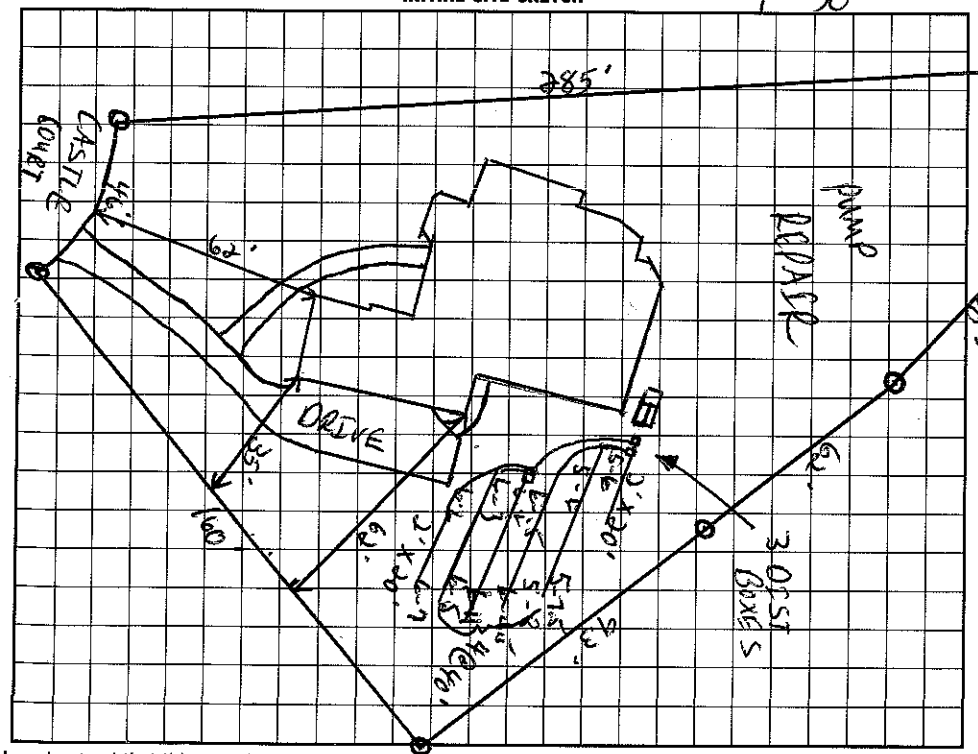

AS BUILT SKETCH

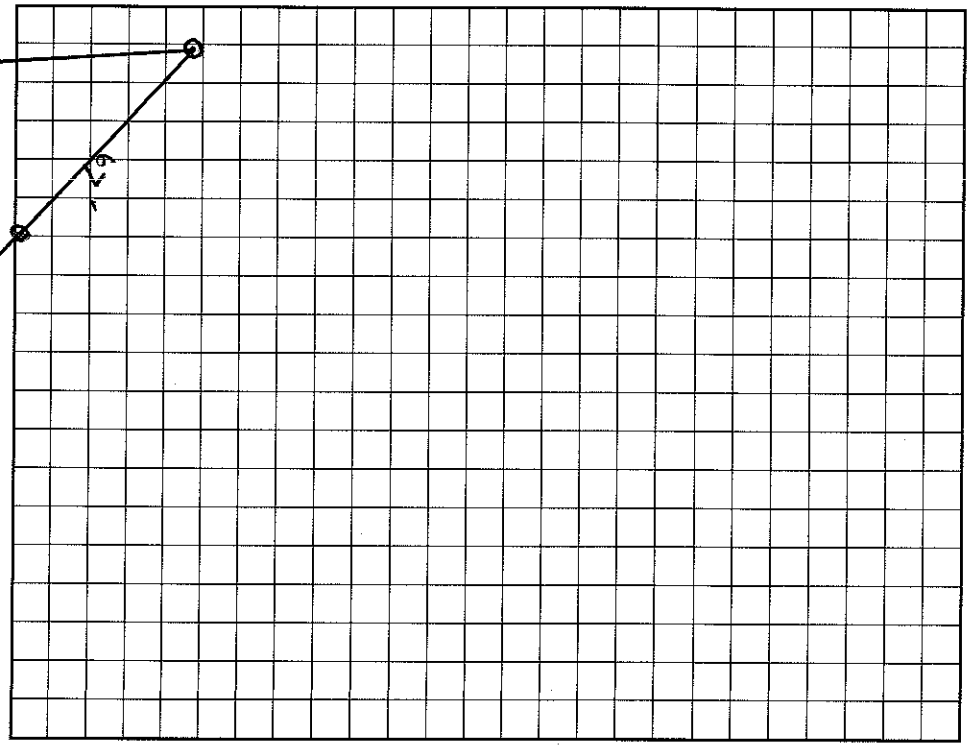

I understand that this permit can be suspended or revoked if any false information is supplied toward securing the permit/any unauthorized changes are made to the site/any unauthorized changes are made in the installation of the system. Improvement Permit with plat valid without expiration. Improvement Permit with site plan valid for sixty months. Authorization to Construct is valid for a period equal to that of Improvement Permit – not to exceed sixty months.

Signed: Craig McRaven date 11-9-98

Improvement Permit by: C. Watson RS date 11/5/98

Authorization to Construct by: C. Watson RS date 11/5/98

Installed by: Little Hawkins

Operation Permit by: Wesley Sparks R.S. date 8/16/99

Existing System Inspection by: date

HEALTH DEPT. COPY: WHITE INSPECTION COPY (FINAL): GREEN OWNER COPY (FINAL): YELLOW INSPECTION COPY (INITIAL): PINK OWNER COPY (INITIAL): GOLD