IREDELL COUNTY HEALTH DEPARTMENT

STATESVI 704-878-5305 130,00 gpd MOORESVILLE 704-664-5281

IMPROVEMENT PERMIT / AUTHORIZATION TO CONSTRUCT / ATION PERMIT / EXISTING SYSTEM INSPECTION

PERMIT# 126645 PIN# ~~4635-91-4095~~ 4635-81-3466 91-4095 DATE 3/8/05

OWNER OR CONTRACTOR Traditional Southern Homes LLC PHONE: Business 980-721-5434 Home

ADDRESS 8533 Glade Ct Huntersville NC 28078

LOCATION 1155, TR Longtree, T R Lake Shore (1st), on Rt.

SUBDIVISION Lakeview Shores BLOCK / SECTION D LOT 22 LOT AREA 0.464c SITE CLASS. PS DESIGN FLOW 480 L.T.A.R. 0.5

Septic Tank: 1000 Gallons; STB 794 Date 6/22/05

Pump Tank: Gallons; PT Date

Pump Make: Model Serial No.

Nitrification Field: No Fields 1 Square Feet 810 Linear Feet 270

No Lines 6@45' Trench Width 24" 8 FOC Max Trench Bottom Depth 36" Gravel Depth —

☒ New System ☐ Repair System Type: I II III IV V VI

System Description: Gravity Panel Block

Repair System Description: LP Panel Block

Maintenance Agreement Required: ☐ Yes ☒ No

☒ House/Mod. Home No. Bedrooms 4

☐ Mobile Home No. Bathrooms

☐ Business No. Employees

☐ Other

Water Supply: ☒ Individual ☐ Public ☐ Community


☐ Slab ☒ Crawl Space ☐ Basement w/plumbing ☐ Basement wo/plumbing

Comments:/Conditions: OR 36" 9 FOC


1"=40'

Comments:/Conditions:

INITIAL SITE SKETCH

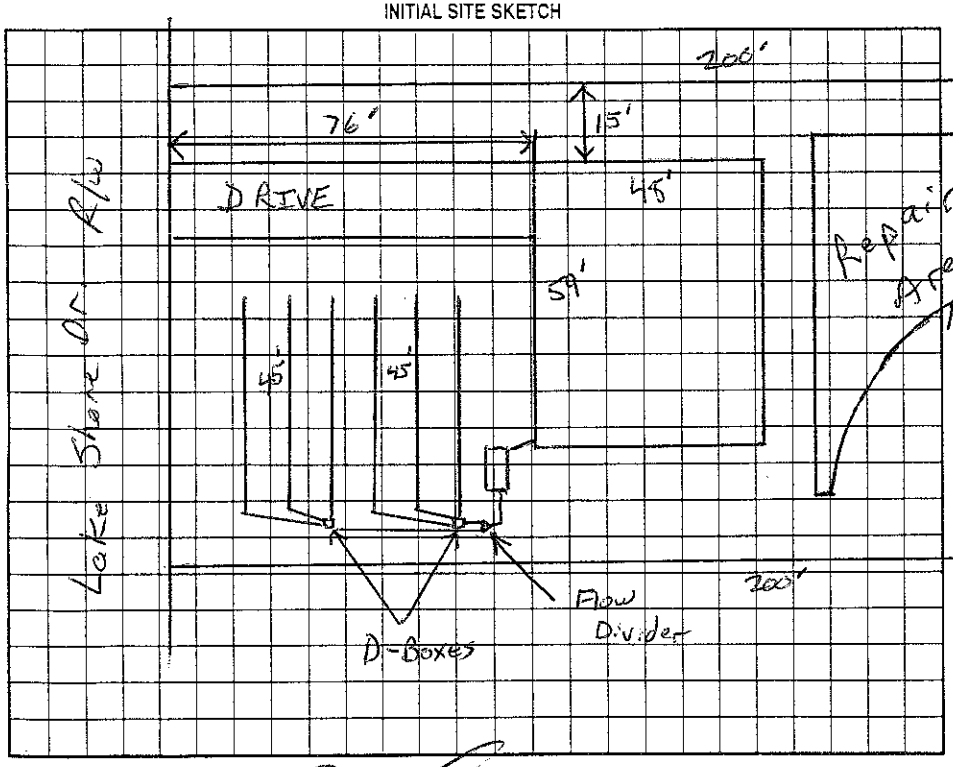

AS BUILT SKETCH

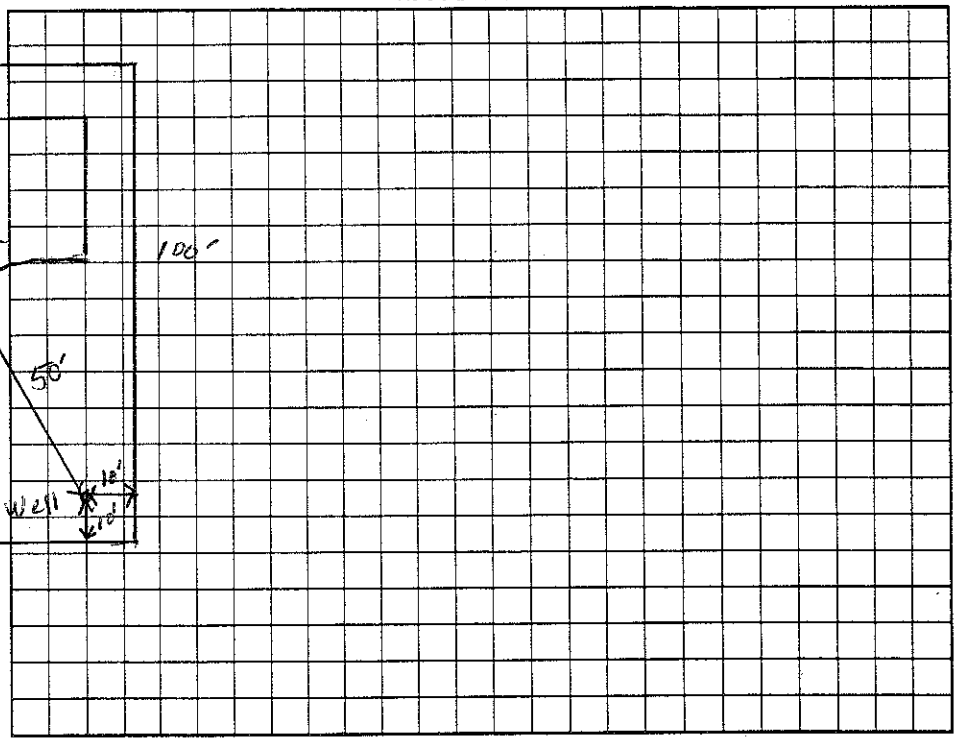

Permit can be suspended or revoked if any false information is supplied toward securing the permit/any unauthorized changes are made to the site/any unauthorized changes are made in the installation of the system. Improvement Permit with plat valid without expiration. Improvement Permit with site plan valid for sixty months. Authorization to Construct is valid for a period equal to that of Improvement Permit – not to exceed sixty months.

Signed: date 5/11-05 Installed by:

Improvement Permit by: RS date 3/8/05 Operation Permit by: Judy Melville date 8-3-05

Authorization to Construct by: RS date 3/8/05 Existing System Inspection by: date

HEALTH DEPT. COPY: WHITE OWNER COPY (FINAL): YELLOW OWNER COPY (INITIAL): PINK