2:30

IREDELL COUNTY HEALTH DEPARTMENT - *ENVIRONMENTAL HEALTH* ☐ STATESVILLE OFFICE 704-878-5305 ☒ MOORESVILLE OFFICE 704-664-5281

IMPROVEMENT PERMIT / AUTHORIZATION TO CONSTRUCT / OPERATION PERMIT / EXISTING SYSTEM INSPECTION

PERMIT # REPAIR PIN # 4635-95-0972 DATE 11-17-11

OWNER HERSCHEL FARMER APPLICANT: SAME PHONE: Home/Cell # 704-995-4780 Business #

SITE ADDRESS 112 SIENNA PACE CT 28117 OWNER / APPLICANT ADDRESS SAME

SITE DIRECTIONS ALCOVE, TEMPLETON, CAMINO REAL, SIENNA PACE

SUBDIVISION COPPER RIDGE BLOCK / SECTION LOT # 4 LOT AREA 1.23 AC DESIGN FLOW 480 L.T.A.R. .3

Septic Tank 1000 Gallons: STB 700 Date 7-24-11

Pump Tank 1000 Gallons: PT 363 Date 8-16

Pump Make ZOELLER Model N98 Serial #

No. Nitrification Fields: No. Lines EXISTING Linear Feet

Trench Width Max Trench Bottom Depth Gravel Depth

☐ New System ☒ Repair ☐ Expansion System Type I II III (IV) V VI

System Description:

Repair System Description: TANKS

Maintenance Agreement Required ☒ YES ☐ NO

☐ GRAVITY ☒ PRESSURE

☒ Residence No. Bedrooms 4

☐ Business No. Persons

☐ Other No. Employees


☐ Slab ☒ Crawl Space

☐ Basement w/plumbing ☐ Basement w/o plumbing


Water Supply
☒ Private
☐ Public
☐ Community

Comments / Conditions ① REPLACE ST & PT ② WILL NEED TO CHECK PUMP FITTINGS & SET 2' PRESSURE HEAD ③ TRY TO PULL OLD TANKS OUT & PUT NEW TANKS IN SAME HOLE ④ MAKE SURE GUTTER DRAINS ARE AWAY FROM TANKS

INITIAL SITE SKETCH

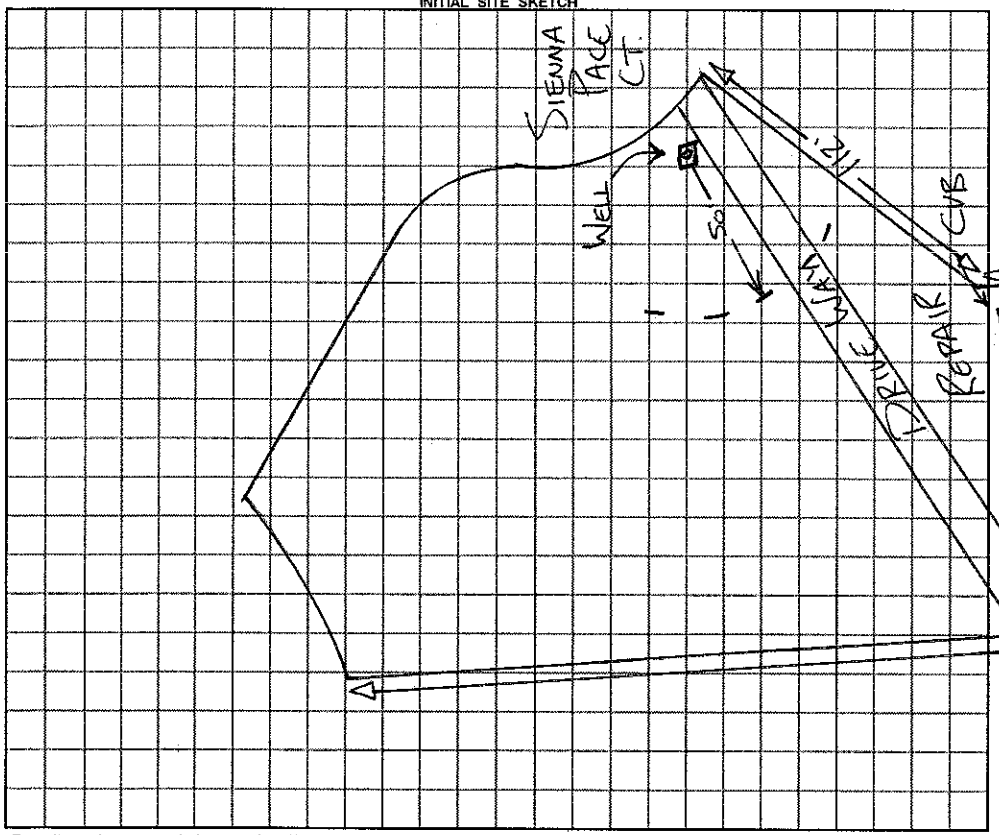

AS BUILT SKETCH

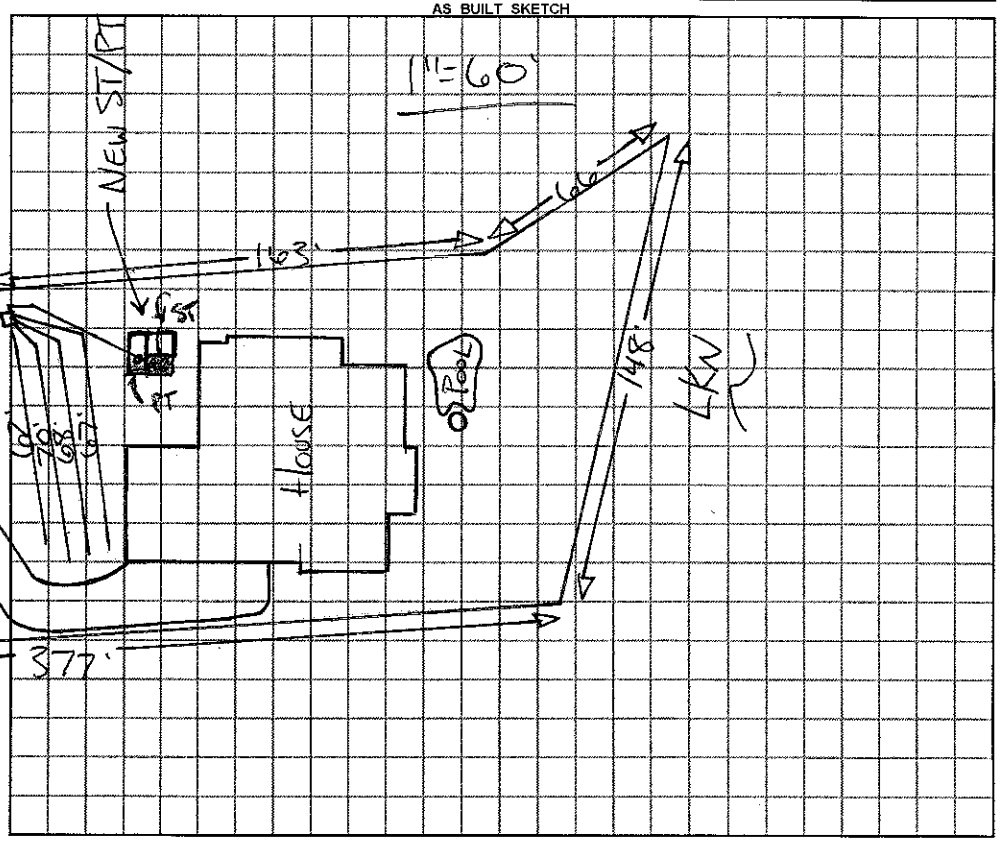

Permit can be suspended or revoked if any false information is supplied toward securing the permit / any unauthorized changes are made to the site / any unauthorized changes are made in the installation of the system.

☐ ***IMPROVEMENT PERMIT*** with plat valid without expiration. ☐ ***IMPROVEMENT PERMIT*** with ~~plat valid without expiration~~ site plan valid 60 mo. ☒ ***AUTHORIZATION TO CONSTRUCT*** valid for period equal to IMPROVEMENT PERMIT--not to exceed 60 mo.

Owner / Applicant Signature: Herschel Farmer Date 11-18-11 Installed by: ENTZ

IMPROVEMENT PERMIT by: REHS Date 11-17-11 OPERATION PERMIT by: REHS Date

AUTHORIZATION TO CONSTRUCT by: REHS Date 11-17-11 Existing System Inspected by: REHS Date

YOU SHOULD CONTACT A LOCATOR SERVICE PRIOR TO ANY EXCAVATION

White Copy – Environmental Health YELLOW COPY (Final) Owner / Applicant PINK COPY (Initial) Owner / Applicant