IREDELL COUNTY HEALTH DEPARTMENT

STATESVILLE 704-878-5305 MOORESVILLE 704-664-5281

IMPROVEMENT PERMIT / AUTHORIZATION TO CONSTRUCT / OPERATION PERMIT / EXISTING SYSTEM INSPECTION

$75.00 Paid

PERMIT# 134 554 PIN# 4635 95 2686.063 4635 95 2800 DATE 4/21/06

OWNER OR APPLICANT Burke Builders of NC, LLC / PATRICK JOSEPH PHONE: Business 704 361 0047 Home

ADDRESS PO Box 3481 Mooresville, NC. 28115

LOCATION Williamson Rd. TR Alcove TR Templeton Tl Camino Real Tl Shenanigans pl., 3rd on (R)

SUBDIVISION Copper Ridge BLOCK / SECTION LOT 3 LOT AREA .57AC SITE CLASS. PS DESIGN FLOW 480 L.T.A.R. .3

Septic Tank: 1500 Gallons; STB Date 10/13/09
Pump Tank: 1500 Gallons; PT Date 7/2/09
Pump Make: Zoeller Model N098 Serial No.
Nitrification Field: No Fields 1 Square Feet 560 Linear Feet 280
No Lines 4070 Trench Width 2 Max Trench Bottom Depth 3' Gravel Depth N/A ☐ Gravity ☒ Pressure

☒ New System ☐ Repair ☐ Expansion System Type: I II III (IV) V VI
System Description: PRES DOSED - 16"PBBPS
Repair System Description: SAME
Maintenance Agreement Required: ☒ Yes ☐ No

☒ House/Mod. Home No. Bedrooms 4
☐ Mobile Home No. Persons
☐ Business No. Employees
☐ Other


Water Supply: ☒ Individual ☐ Public ☐ Community

☐ Slab ☒ Crawl Space ☐ Basement w/plumbing ☐ Basement wo/plumbing


Comments:/Conditions: MAINTENANCE CONTRACT REQUIRED
IMPROVEMENT PERMIT ONLY - HOUSE PLAN APPROVAL REQUIRED
SIMTEC# FILTER REQUIRED. 1"=50'

Comments:/Conditions: 3/16" hole drilled 1/4/08 checked lines & set pressure (2ft)

INITIAL SITE SKETCH

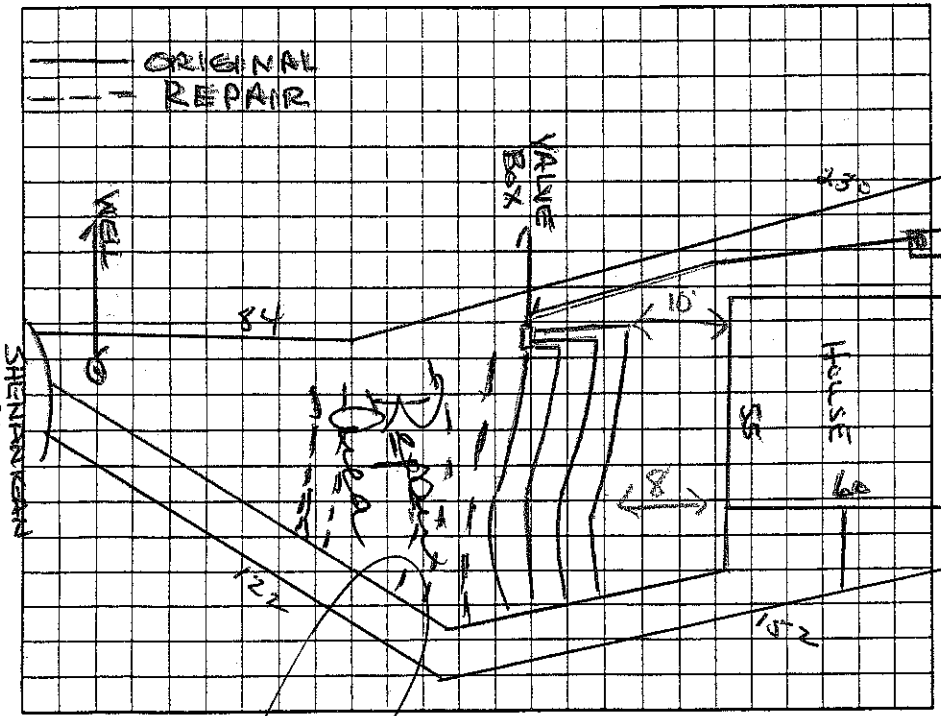

AS BUILT SKETCH

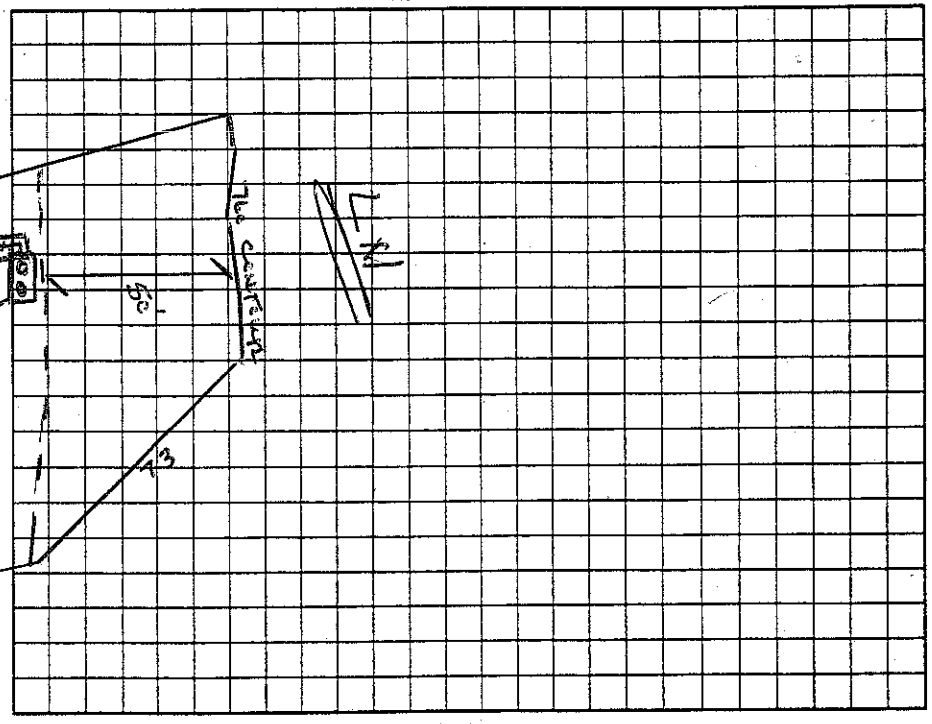

Permit can be suspended or revoked if any false information is supplied toward securing the permit/any unauthorized changes are made to the site/any unauthorized changes are made in the installation of the system. Improvement Permit with plat valid without expiration ☐ Improvement Permit with site plan valid for sixty months ☐ Authorization to Construct is valid for a period equal to that of Improvement Permit – not to exceed sixty months.

Signed: X date 4/27/06

Improvement Permit by: Wesley Sparks RS. date 4/21/06

Authorization to Construct by: Wesley Sparks RS date 4/3/07

Installed by: Rays Septic date Feb-21-08

Operation Permit by: date

Existing System Inspection by: date

HEALTH DEPT. COPY: WHITE OWNER COPY (FINAL): YELLOW OWNER COPY (INITIAL): PINK