IREDELL COUNTY HEALTH DEPARTMENT

Authorization to Construct

STATESVILLE 704-878-5305 MOORESVILLE 704-664-5281

IMPROVEMENT PERMIT / CERTIFICATE OF COMPLETION / OPERATION PERMIT / EXISTING SYSTEM INSPECTION

PROPERTY DESCRIPTION NO. 17810 DATE 6/10/96

OWNER OR CONTRACTOR RI Homes TAX MAP NO. 2F-B-10

ADDRESS 2900 B I 85 Service Charlotte 28208 PHONE: Business 391-3715 Home 4636-00-5409 Watershed: ☑ Yes ☐ No

LOCATION Brawley School - TL Isle of Pines - Wynward Ln - Right side of North Shore Dr.

SUBDIVISION North Shore BLOCK / SECTION II LOT 34 LOT AREA SITE CLASS. PS DESIGN FLOW 480 gpd T.A.R. .3 gpd/ft²

Septic Tank: 1000 Gallons; STB 794 Date 9/15/95

Pump Tank: Gallons; PT Date

Pump Make: Model Serial No.

Nitrification Field: No Fields 1 Square Feet 1200 Linear Feet 400

No Lines 4 Trench Width 36" Max Trench Bottom Depth 36" Gravel Depth 10 N/A

☑ New System ☐ Repair System Type: I, II, (III), IV, V, VI

System Description: Gravity Chambered

Repair System Description: Gravity/Pump Pond

Maintenance Agreement Required: ☐ Yes ☑ No

☑ House/Mod. Home ☐ Mobile Home ☐ Business ☐ Other

No. Bedrooms 4 No. Bathrooms 3 No. Employees


☐ Slab ☑ Crawl Space ☐ Basement w/plumbing ☐ Basement wo/plumbing

Water Supply: ☐ Individual ☒ Community ☐ Public


Comments:

Comments:

INITIAL SITE SKETCH 1" = 40'

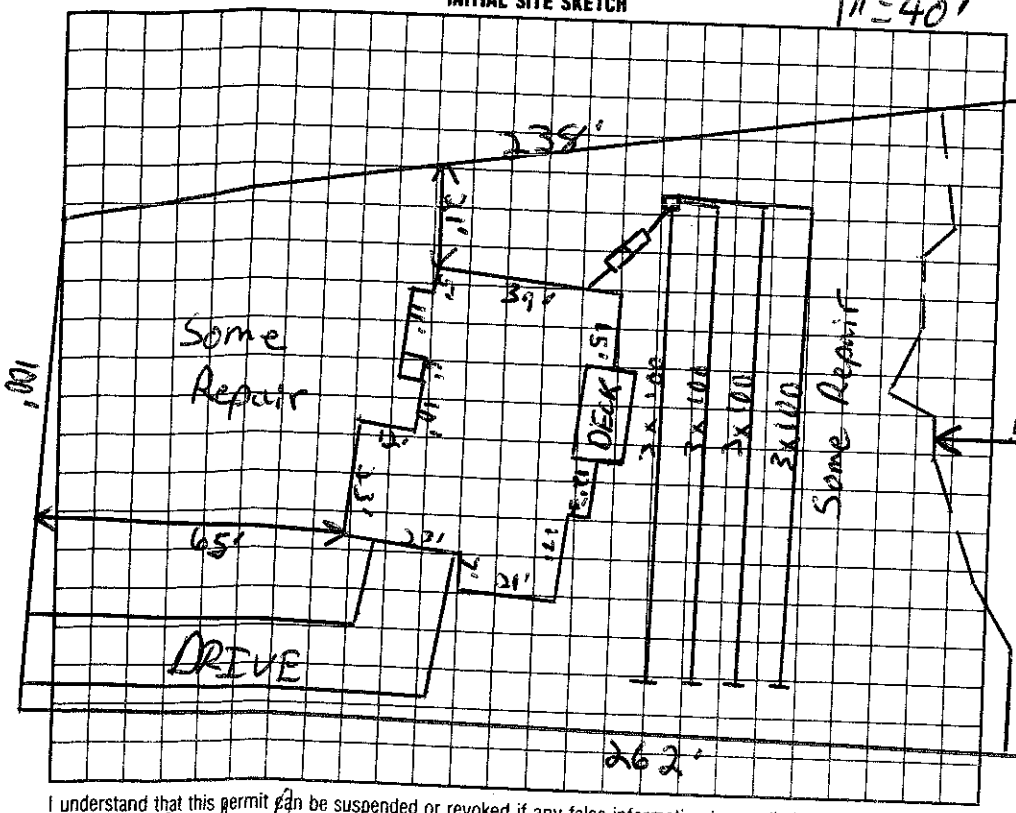

AS BUILT SKETCH

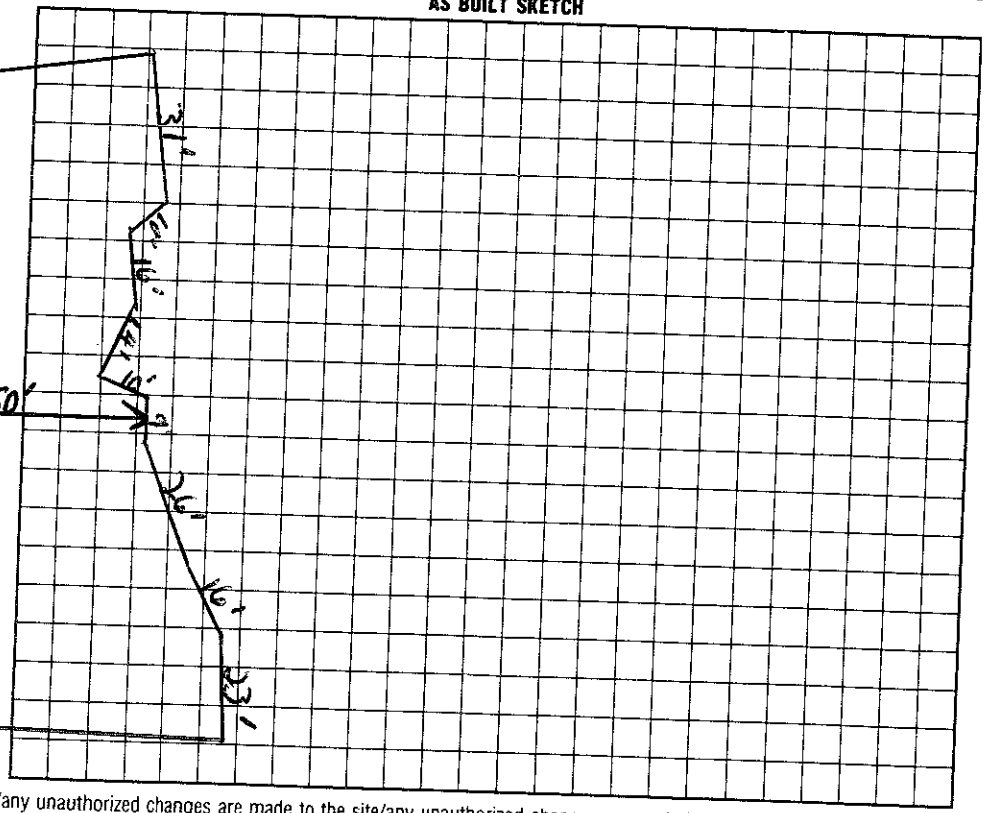

I understand that this permit can be suspended or revoked if any false information is supplied toward securing the permit/any unauthorized changes are made to the site/any unauthorized changes are made in the installation of the system.

Signed: Steve Austin P.M.

Improvement Permit by: C. Bailey Teem EHSI date 6/10/96

Authorization to Existing System Inspection by: C. Bailey Teem EHSI date 6/10/96

Installed by: Iron Horse Grading

Certificate of Completion by: date

Operation Permit by: Wesley Sparks R.S. date 10/29/96

HEALTH DEPT. COPY: WHITE INSPECTION COPY (FINAL): GREEN OWNER COPY (FINAL): YELLOW INSPECTION COPY (INITIAL): PINK OWNER COPY (INITIAL): GOLD

Construct Authorization to Construct is Valid for 6 Months