...ELL COUNTY HEALTH DEPARTMENT

STATESVILLE 704-878-5305 MOOR... 704-664-5281

IMPROVEMENT PERMIT / CERTIFICATE OF COMPLETION / OPERATION PERMIT / EXISTING SYSTEM INSPECTIO...N

ALTERNATE SYSTEM TO CONSIDER

PROPERTY DESCRIPTION NO. 25319 DATE 9/15/97 TAX MAP NO. 26 23 B 32 Watershed: ☑ Yes ☐ No

OWNER OR CONTRACTOR CRESCENT RESOURCES (STEVE VANT) PHONE: Business 663-6905 JACOBS Home 664-8527

ADDRESS 400 S TRYON ST 4636-00-6360

LOCATION BRAWLEY SCHOOL RD - TL ISLE OF PINES - TL COVE CREEK - TL WYNSWEPT - TL NORTH SHORE - IN CUL-DE-SAC

SUBDIVISION NORTH SHORE BLOCK / SECTION II LOT 32 LOT AREA ± SITE CLASS. PS DESIGN FLOW 480 L.T.A.R. .3

Septic Tank: 1000 Gallons; STB 794 Date 2/25/98

Pump Tank: 1000 Gallons; PT 27 Date 4/3/98

Pump Make: Bauld Model ME 7/2H Serial No HA728864

Nitrification Field: No Fields 1 Square Feet 560 Linear Feet 280

No Lines 4 Trench Width ~~36"~~ 24" Max Trench Bottom Depth 36" Gravel Depth N/A

☑ New System ☐ Repair System Type: I, II, III, (IV), V, VI

System Description: PUMP PANEL

Repair System Description: SAME

Maintenance Agreement Required ☐ Yes ☐ No

☑ House/Mod. Home ☐ Mobile Home ☐ Business ☐ Other

No. Bedrooms 4 No. Bathrooms 4 No. Employees ___


☐ Slab ☐ Crawl Space ☑ Basement w/plumbing ☐ Basement wo/plumbing

Water Supply: ☐ Individual ☑ Community ☐ Public

Comments: KEEP TANKS 50' FROM LAKE - KEEP LINES 25' UPSLOPE OF HOUSE. - DO NOT GRADE OR CUT SEPTIC AREA OR REPAIR. - DRIVE CANNOT GO OVER LINES - SUPPLY LINE IS TO BE SLEEVED UNDER DRIVE.

Comments:

INITIAL SITE SKETCH

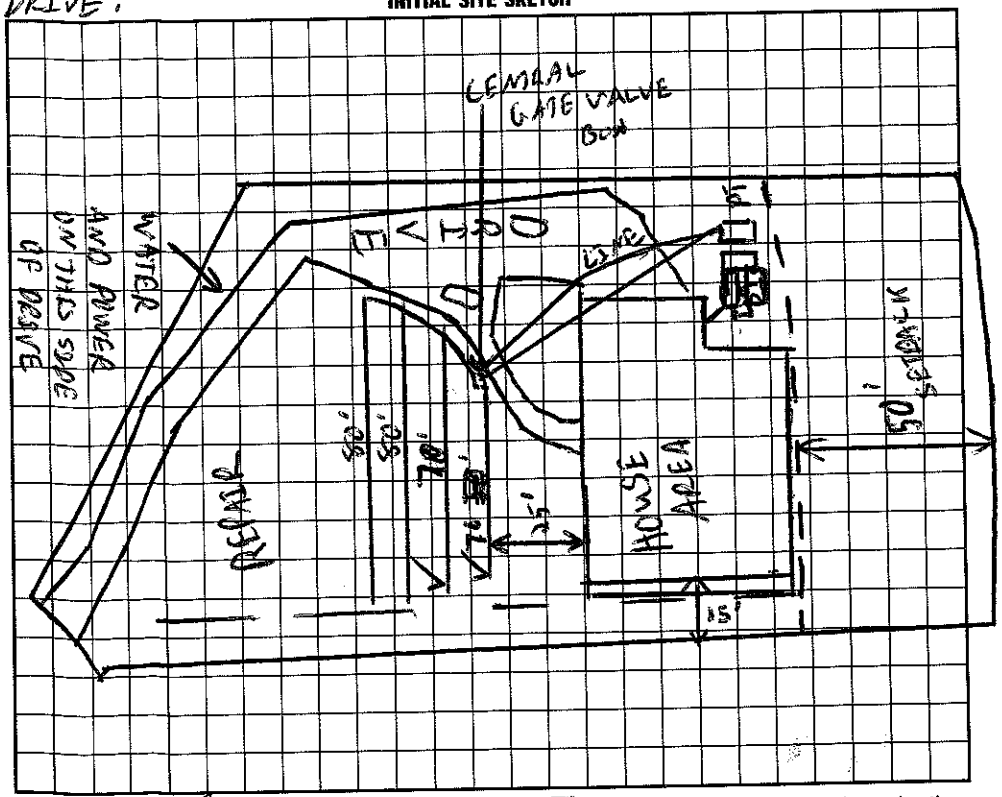

AS BUILT SKETCH

I understand that this permit can be suspended or revoked if any false information is supplied toward securing the permit/any unauthorized changes are made to the site/any unauthorized changes are made in the installation of the system. Improvement Permit is valid for 60 months from date of issuance.

Signed: _____

Improvement Permit by: _____ date 9/15/97

Inspection by: _____ date 9/15/97

Installed by: FJ ERVIN

Certificate of Completion by: _____ date 9/16/98

Operation Permit by: _____ date _____

WHITE COPY: WHITE INSPECTION COPY (FINAL): GREEN OWNER COPY (FINAL): YELLOW INSPECTION COPY (INITIAL): PINK OWNER COPY (INITIAL): GOLD