IREDELL COUNTY HEALTH DEPARTMENT

STATESVILLE 704-878-5305 MOORESVILLE 704-664-5281

IMPROVEMENT PERMIT / CERTIFICATE OF COMPLETION / OPERATION PERMIT / EXISTING SYSTEM INSPECTION

PROPERTY DESCRIPTION NO. 20651 DATE 3-22-95 TAX MAP NO. 26-23-13-31 Watershed: ☑ Yes ☐ No

OWNER OR CONTRACTOR Robert Ingram Homes PHONE: Business 391 3715 Home

ADDRESS 2900 B I-85 Service Road Charlotte N.C. - 46360-00-7240 WS4-CA

LOCATION Brawley School Rd TL Isle of Pine TR Cove Creek TL Wynswept TL Wynnway TL North Shore Circle

SUBDIVISION North Shore BLOCK / SECTION II LOT 31 LOT AREA 1.70 acres SITE CLASS. PS DESIGN FLOW 480 L.T.A.R. 1.3

Septic Tank: 1000 Gallons; STB 794 Date 10/26/95

Pump Tank: _____ Gallons; PT _____ Date _____

Pump Make: _____ Model _____ Serial No. _____

Nitrification Field: No Fields 1 Square Feet _____ Linear Feet 270'

No Lines 3 Trench Width 24" Max Trench Bottom Depth 30" Gravel Depth Panel

☑ New System ☐ Repair System Type: I, II, III, IV, V, VI

System Description: Gravity Poras Block Panel " " " "

Repair System Description: _____

Maintenance Agreement Required: ☐ Yes ☑ No

☐ House/Mod. Home No. Bedrooms 4

☐ Mobile Home No. Bathrooms 3½

☐ Business No. Employees _____

☐ Other _____


☐ Slab ☐ Crawl Space ☑ Basement w/plumbing ☐ Basement wo/plumbing

Water Supply: ☐ Individual ☑ Community ☐ Public


Comments:

Comments:

INITIAL SITE SKETCH

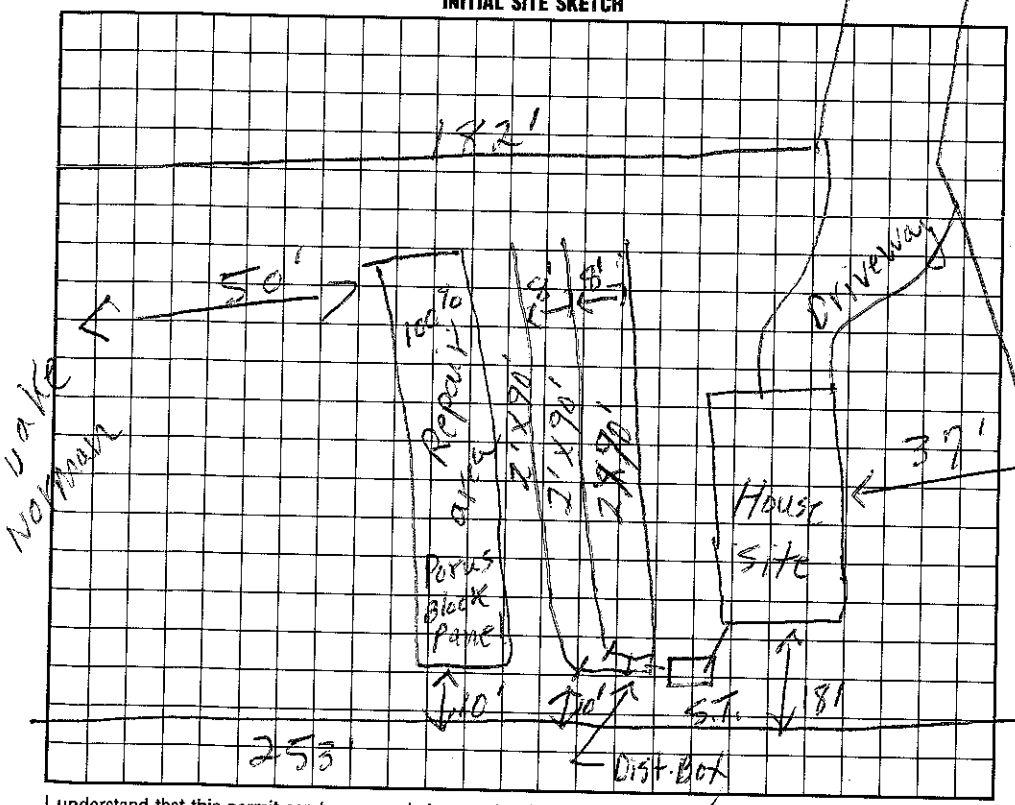

AS BUILT SKETCH

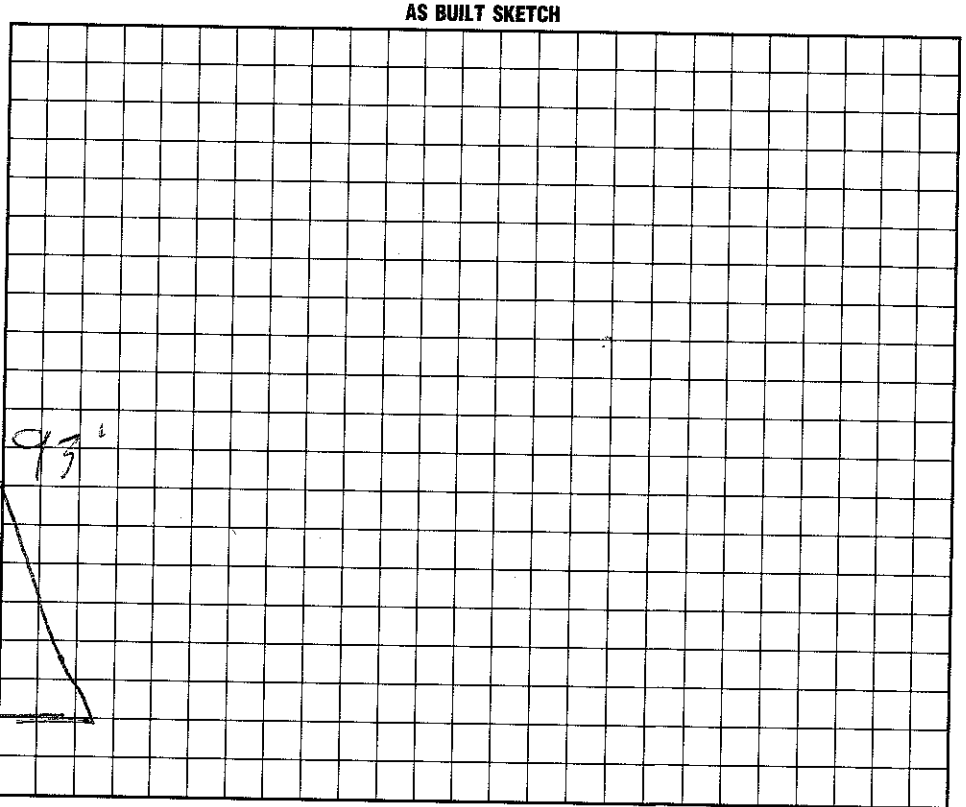

I understand that this permit can be suspended or revoked if any false information is supplied toward securing the permit/any unauthorized changes are made to the site/any unauthorized changes are made in the installation of the system. Improvement Permit is valid for 60 months from date of issuance.

Signed: X _____ 3-22-95

Improvement Permit by: E.C. Moore date 3-22-95

Existing System Inspection by: _____ date _____

Installed by: Ken Paynton

Certificate of Completion by: Wesley Sparks R.S date 2/7/96

Operation Permit by: Wesley Sparks R.S date 2/7/96

HEALTH DEPT. COPY: WHITE INSPECTION COPY (FINAL): GREEN OWNER COPY (FINAL): YELLOW INSPECTION COPY (INITIAL): PINK OWNER COPY (INITIAL): GOLD