IREDELL COUNTY HEALTH DEPARTMENT

STATESVILLE 704-878-5305 4636-00-7680 MOORESVILLE 704-664-5281

IMPROVEMENT PERMIT / CERTIFICATE OF COMPLETION / OPERATION PERMIT / EXISTING SYSTEM INSPEC[illegible]

PROPERTY DESCRIPTION NO. 14779 DATE _____ TAX MAP NO. 26 28328 Watershed: ☑ Yes ☐ No

OWNER OR CONTRACTOR Robert Ingram Homes PHONE: Business 391-3715 Home _____

ADDRESS 2900 B-185 S Spence Road, Charlotte

LOCATION 1100 LF on 1113, Rt on cove Creek, Lf on Wynnsprt, Rt on Wynward, Lf on North Shore, Rt on Lenda, Lf

SUBDIVISION North Shore BLOCK / SECTION II LOT 28 LOT AREA 20,000 sq ft SITE CLASS. B/PBDS DESIGN FLOW 480 L.T.A.R. 0.3

Septic Tank: _____ Gallons; STB _____ Date _____
Pump Tank: _____ Gallons; PT _____ Date _____
Pump Make: _____ Model _____ Serial No. _____
Nitrification Field: No Fields ____ Square Feet _____ Linear Feet _____
No Lines _____ Trench Width _____ Max Trench Bottom Depth _____ Gravel Depth N/A

☑ New System ☐ Repair System Type: I, II, III, IV, V, VI
System Description: LPPBDS
Repair System Description: same
Maintenance Agreement Required: ☐ Yes ☐ No

☑ House/Mod. Home No. Bedrooms 4
☐ Mobile Home No. Bathrooms 2½
☐ Business No. Employees ____
☐ Other _____
☐ Slab ☑ Crawl Space ☐ Basement w/plumbing ☐ Basement wo/plumbing

Water Supply:
☐ Individual
☑ Community
☐ Public


Comments:

Comments: pressure PBDS Repair 90 Lines OK by KS

INITIAL SITE SKETCH

See IP Dated 12/9/94 by David Hinson

AS-BUILT SKETCH

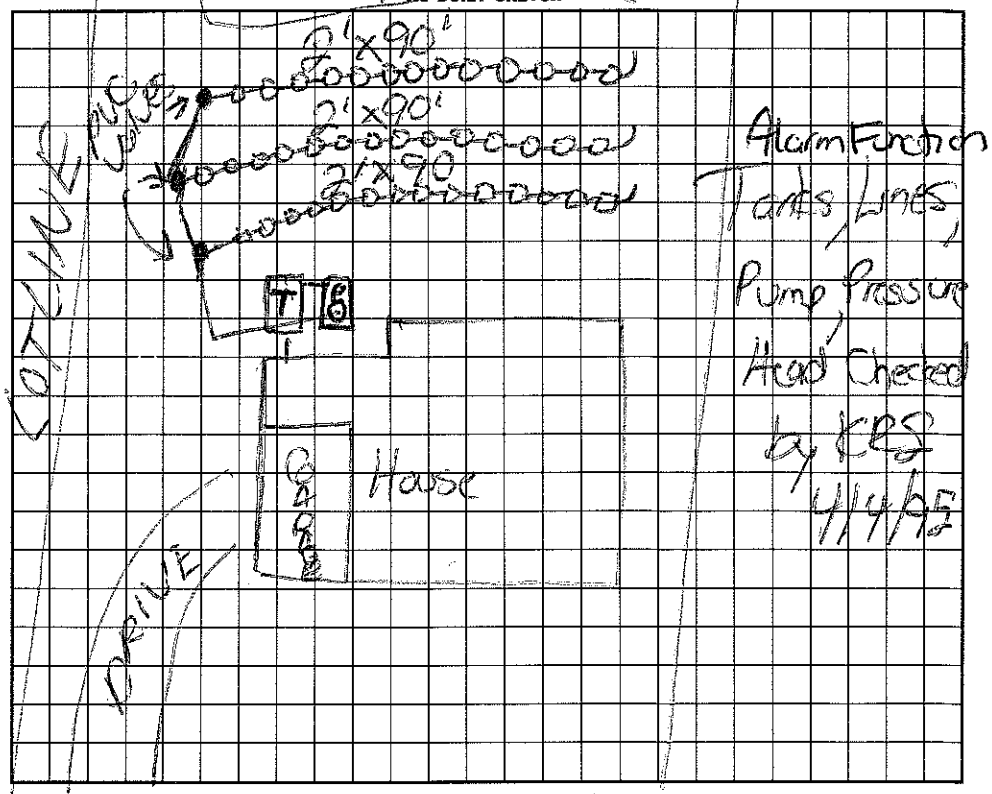

I understand that this permit can be suspended or revoked if any false information is supplied toward securing the permit/any unauthorized changes are made to the site/any unauthorized changes are made in the installation of the system. Improvement Permit is valid for 60 months from date of issuance.

Signed: _____

Improvement Permit by: DRH date 12/9/94

Existing System Inspection by: _____ date _____

Installed by: Ironhorse Grading

Certificate of Completion by: _____ date _____

Operation Permit by: [signature] RS date 5/18/95

HEALTH DEPT. COPY: WHITE INSPECTION COPY (FINAL): GREEN OWNER COPY (FINAL): YELLOW INSPECTION COPY (INITIAL): PINK OWNER COPY (INITIAL): GO[illegible]